

MISSISSIPPI DEPARTMENT OF NATURAL RESOURCES

Bureau of Land and Water Resources

Southport Mall

P.O. Box 10631

Jackson, Mississippi 39209

WATER WELL DRILLERS LOG

Jackson
K 2106
1-27-81
1-27-81

Coast Water Well Sew. Inc. Jackson
firm name county well located

LANDOWNER: Robert Murphy

description of formations encountered

from

to

P.O. Box 235C
Ocean Springs, Miss.
(mailing address) 39564

Top soil	0	2'
R. Clay	2'	15'
M. C. sand - g -	15'	100'
Blue Clay	100'	240'
O. sand	240'	260'

WELL LOCATION:

sec. 9 T. 6 S. R. 7 W. of LAUCLEAVE
(distance) miles (direction) (nearest town)

WELL PURPOSE:

(home, irrigation, municipal, industrial)

WELL COMPLETION DATA:

- (1) diameter (inches) 2"
- (2) total depth (feet) 260'
- (3) static water level (feet) 25' below top of ground.
- (4) casing PVC, 250' (material), (depth)
- 5" (size) if telescope see back.
- (5) screen 10' (length), 250' (depth to top)
- 5" (size), PVC (material)
- (6) pump 1 h.p. (HP), 9 (yield gpm)
- Elec. (type power)
- (7) electric log No. (yes or no)
- (organization running log)

(8) How well bottom plugged
Back Wash Valve

DRILLERS REMARKS:


DEPT. OF NATURAL RESOURCES
BUREAU OF LAND & WATER RESOURCES

APR - 6 1981

RECEIVED

If well telescopes please sketch and show depths.

GROUND LEVEL

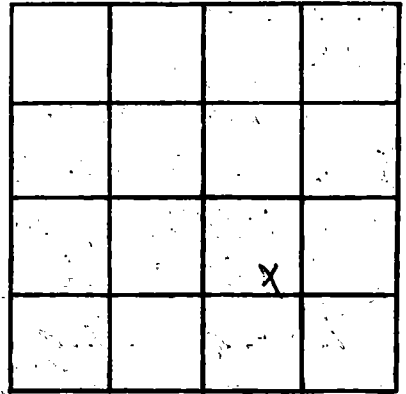

SECTION 9

Please indicate well location X.

ADDITIONAL INFORMATION

If more than one screen, show locations of each on sketch.