

MISSISSIPPI DEPARTMENT OF NATURAL RESOURCES

Bureau of Land and Water Resources

Southport Mall

P.O. Box 10631

Jackson, Mississippi 39209

WATER WELL DRILLERS LOG

JACKSON
K 2107
5/27/81

15-27-81 date well completed

Coastal Water Well Serv. firm name

Jackson county well located

LANDOWNER

Home of Grace

description of formations encountered

from

to

WELL LOCATION:

sec. 7 T. 6 S. R. 2 E. 2 1/2 miles W of VANLEAVE (distance) (direction) (nearest town)

WELL PURPOSE: Home (home, irrigation, municipal, industrial)

WELL COMPLETION DATA:

- (1) diameter (inches) 2"
- (2) total depth (feet) 261'
- (3) static water level (feet) 66' below top of ground.
- (4) casing PVC 251' (material) (depth)
- 2" (size) If telescope see back.
- (5) screen 10' 251' (length) (depth to top)
- 2" PVC (size) (material)
- (6) pump Elect. 7 1/2 (HP) (yield gpm)
- Elect. (type power)
- (7) electric log No. (yes or no)
- (organization running log)

Top soil 0 5'
Red coarse sand 5' 60'
Red coarse sand + gravel 60' 119'
Blue clay + streak of sand 119' 148'
Blue clay 148' 217'
gray coarse sand 217' 261'


(8) how well bottom plugged. back wash valve

DRILLERS REMARKS:



If well telescopes please sketch and show depths.

GROUND LEVEL

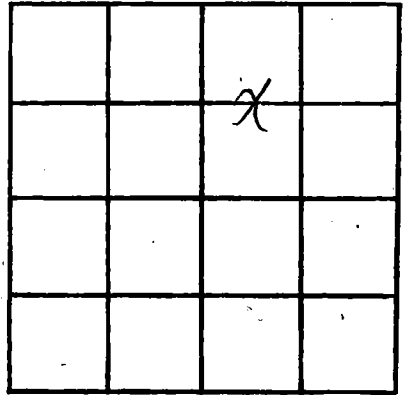

SECTION 7

Please indicate well location X.

ADDITIONAL INFORMATION

If more than one screen,
show locations of each on sketch.