

# MISSISSIPPI DEPARTMENT OF NATURAL RESOURCES

Bureau of Land and Water Resources

Southport Mall

P.O. Box 10631

Jackson, Mississippi 39209

## WATER WELL DRILLERS LOG

Jackson  
K 2109  
6-5-81

6-5-81 19 Cross Water Well Sewer Jackson  
date well completed firm name county well located

Landowner: Universal Church

Vanclave,  
Miss. 39564  
(mailing address)

### WELL LOCATION:

sec. 16 T. 6 N. R. 7 E  
N miles of VANCLEAVE (distance) (direction) (nearest town)

### WELL PURPOSE:

(home, irrigation, municipal, industrial)

### WELL COMPLETION DATA:

- (1) diameter (inches) 2"
- (2) total depth (feet) 187'
- (3) static water level (feet) 38' below above top of ground
- (4) casing PVC 177' (material) (depth)
- (5) screen 10' 177' (length) (depth to top)  
2" PVC (size) (material)
- (6) pump 1 hp. 8 (HP) (yield gpm)  
Elec. (type power)
- (7) electric log No (yes or no)  
(organization running log)

description of formations encountered	from	to
<u>Top soil</u>	<u>0</u>	<u>5'</u>
<u>Blue Clay &amp; wood</u>	<u>5'</u>	<u>50'</u>
<u>Blue Clay</u>	<u>50'</u>	<u>82'</u>
<u>Red coarse sand</u>	<u>82'</u>	<u>115'</u>
<u>Blue Clay</u>	<u>115'</u>	<u>140'</u>
<u>Gray coarse sand</u>	<u>140'</u>	<u>155'</u>
<u>Blue Clay</u>	<u>155'</u>	<u>166'</u>
<u>Gray coarse sand</u>	<u>166'</u>	<u>187'</u>




DRILLERS REMARKS:

(8) how well bottom plugged?  
Back Wash Valve

If well telescopes please sketch and show depths.


GROUND LEVEL

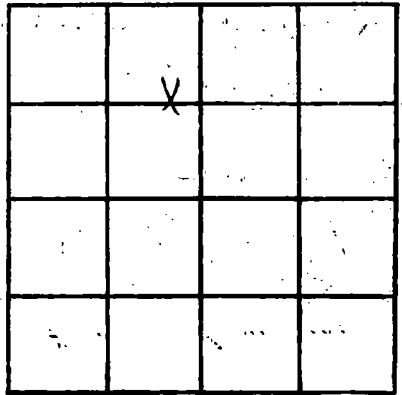

SECTION 16

Please indicate well location X.

ADDITIONAL INFORMATION

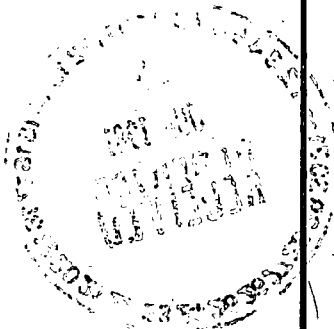

If more than one screen, show locations of each on sketch.