

MISSISSIPPI DEPARTMENT OF NATURAL RESOURCES

Bureau of Land and Water Resources

Southport Mall

P.O. Box 10631

Jackson, Mississippi 39209

WATER WELL DRILLERS LOG

Jackson
K2170
6-22-81

6-22-81 date well completed  
 Coastal Water Well Service, Jackson firm name  
 Jackson county well located


LANDOWNER: Jan Belinski  
P.O. Box 718  
Gautier, Miss.  
 (calling address) 39553

WELL LOCATION:  
 sec. 326 R. 7  
4 miles SOUTH of VAN CLEAVE  
 (distance) (direction) (nearest town)

WELL PURPOSE: Home  
 (home, irrigation, municipal, industrial)

- WELL COMPLETION DATA:
- (1) diameter (inches) 2"
  - (2) total depth (feet) 375'
  - (3) static water level (feet) 54' <sup>below</sup> <sub>above</sub> top of ground.
  - (4) casing PVC, 365'  
 (material) (depth)
  - 2" If telescope see back.  
 (size)
  - (5) screen 10', 365'  
 (length) (depth to top)
  - 2" PVC  
 (size) (material)
  - (6) pump 1HP, 9-  
 (type power) (yield gpm)
  - Electric
  - (7) electric log No-  
 (yes or no)
  - \_\_\_\_\_  
 (organization running log)
  - (8) back wash valve  
 how well bottom plugged

description of formations encountered	from	to
Top soil	0	2'
Red Clay	2'	10'
Gray Clay	10'	18'
Blue Clay	18'	150'
Gray coarse sand & gravel	-	-
blue Clay	150'	212'
blue Clay	212'	342'
Gray coarse sand	342'	375'

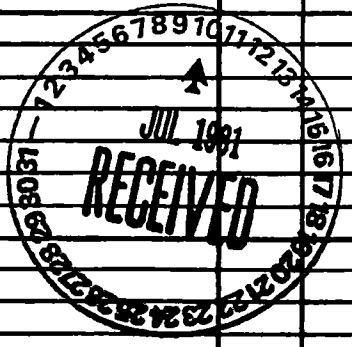

DRILLERS REMARKS:

If well telescopes please sketch and show depths.

GROUND LEVEL

		X	

SECTION 32

Please indicate well location X.

ADDITIONAL INFORMATION



If more than one screen, show locations of each on sketch.