

MISSISSIPPI DEPARTMENT OF NATURAL RESOURCES

Bureau of Land and Water Resources

Southport Mall

P.O. Box 10631

Jackson, Mississippi 39209

WATER WELL DRILLERS LOG

JACKSON
K 2111
8-14-81

8-14-81 19 Coast Water Well Saw. Jackson
date well completed firm name county well located

LANDOWNER: Lenny Lett
Box 30A
Ocean Springs, Miss.
(mailing address) 39564

WELL LOCATION:
sec. 9 T. 6 S. R. 7 E.
1/2 miles (distance) N (direction) of VANORLEAVE (nearest town)

WELL PURPOSE: Home
(home, irrigation, municipal, industrial)

WELL COMPLETION DATA:

(1) diameter (inches) 2"

(2) total depth (feet) 285'

(3) static water level (feet) 38' below above top of ground.

(4) casing PVC 275'
(material) (depth)

2" (size) if telescope see back.

(5) screen 1.0' 275'
(length) (depth to top)

2" PVC
(size) (material)

(6) pump 1/2 HP 8-
(HP) (yield gpm)

Elec.
(type power)

(7) electric log No.
(yes or no)

(organization running log)

(8) how well bottom plugged
Back wash valve


description of formations encountered	from	to
Top soil	0	2'
Red Clay	2'	19'
Red coarse sand	19'	90'
Blue Clay	90'	185'
Blue Clay & (shale) sand	185'	216'
Blue Clay	216'	246'
Gray fine sand	246'	260'
Gray coarse sand	260'	285'



DRILLERS REMARKS:

If well telescopes please sketch and show depths.

GROUND LEVEL

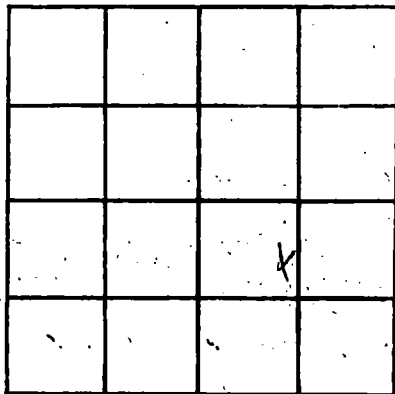

SECTION 9

Please indicate well location X.

ADDITIONAL INFORMATION

If more than one screen, show locations of each on sketch.