

MISSISSIPPI DEPARTMENT OF NATURAL RESOURCES

Bureau of Land and Water Resources

Southport Mall

P.O. Box 10631

Jackson, Mississippi 39209

WATER WELL DRILLERS LOG

JACKSON  
K 2/12  
8-24-81

8-24-81  
date well completed

81 Coast Water Well Sew. Inc. Jackson  
firm name

county well located

LANDOWNER:

Lere Young  
Box 203

description of formations encountered

from to

Osborne Springs, Miss.  
(mailing address) 39564

Top soil	0	5'
Red Clay	5'	24'
Blue Clay	24'	39'
White Coarse sand	39'	130'
Blue Clay	130'	245'
Gray Coarse sand	245'	258'

WELL LOCATION:

sec 37 T 6 E R 7  
5 miles 560 of VANLEAVE  
(distance) (direction) (nearest town)

WELL PURPOSE:

(home, irrigation, municipal, industrial)

None


WELL COMPLETION DATA:

- (1) diameter (inches) 2"
- (2) total depth (feet) 258'
- (3) static water level (feet) 22' below top of ground
- (4) casing PVC 248' (material) (depth)
- (5) screen 2" 10' (size) (length) 248' (depth to top)
- (6) pump 2" 1 h.p. 9 (size) (HP) (yield gpm) PVC (material)
- (7) electric log No. (type power) (yes or no)

(organization running log)

(8) how well bottom plugged? Pack Wash Valve

DRILLERS REMARKS:

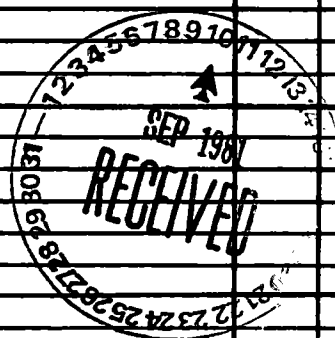

If well telescopes please sketch and show depths.

GROUND LEVEL

	A		

SECTION 37

Please indicate well location X.

ADDITIONAL INFORMATION

If more than one screen, show locations of each on sketch.