

MISSISSIPPI DEPARTMENT OF NATURAL RESOURCES

Bureau of Land and Water Resources

Southport Mall

P.O. Box 10631

Jackson, Mississippi 39209

WATER WELL DRILLERS LOG

JACKSON  
K 2113  
7-17-81

7-17-81 19 Coast Water Well Service Jackson  
date well completed firm name county well located

LANDOWNER: Duff Jenkins  
5006 Bay Ave  
Miss Point, Miss.  
(mailing address) 39563

WELL LOCATION:  
sec. 10 T. 6 S. R. 7 E  
1/2 miles E of VAN CLEAVE  
(distance) (direction) (nearest town)

WELL PURPOSE: Home  
(home, irrigation, municipal, industrial)

- WELL COMPLETION DATA:
- (1) diameter (inches) 2"
  - (2) total depth (feet) 332'
  - (3) static water level (feet) 59' below top of ground.
  - (4) casing PVC, 322'  
(material) (depth)
  - 2" If telescope see back.  
(size)
  - (5) screen 10', 322'  
(length) (depth to top)
  - 2" PVC  
(size) (material)
  - (6) pump 1/2 HP, 8 gal  
(HP) (yield/gpm)
  - Electric  
(type power)
  - (7) electric log           
(yes or no)
  - (organization running log)
  - (8) how well bottom plugged  
Back wash valve

description of formations encountered	from to	
	feet	feet
<u>Top soil</u>	<u>0</u>	<u>2'</u>
<u>Red Clay</u>	<u>2'</u>	<u>19'</u>
<u>Red med. sand</u>	<u>19'</u>	<u>32'</u>
<u>Blue Clay</u>	<u>32'</u>	<u>100'</u>
<u>Red fine sand</u>	<u>100'</u>	<u>128'</u>
<u>Blue Clay</u>	<u>128'</u>	<u>280'</u>
<u>Gray fine sand</u>	<u>280'</u>	<u>300'</u>
<u>Gray coarse sand</u>	<u>300'</u>	<u>332'</u>

DEPT. OF NATURAL RESOURCES  
BUREAU OF LAND & WATER RESOURCES


AUG 14 1981

RECEIVED

DRILLERS REMARKS:

If well telescopes please sketch and show depths.

GROUND LEVEL

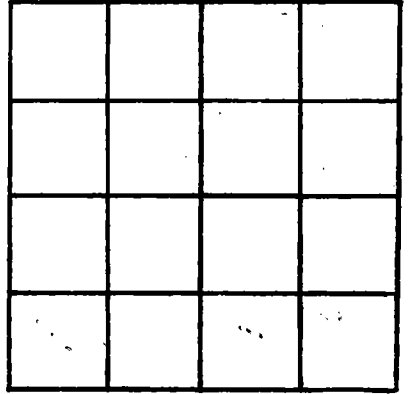

SECTION \_\_\_\_\_

Please indicate well location X.

ADDITIONAL INFORMATION

If more than one screen,  
show locations of each on sketch.