

MISSISSIPPI DEPARTMENT OF NATURAL RESOURCES

Bureau of Land and Water Resources

Southport Mall

P.O. Box 10631

Jackson, Mississippi 39209

WATER WELL DRILLERS LOG

8

JACKSON  
K 2715  
9-3-81

9-3-81 19 *Coast Water Well Serv. Inc.* *Jackson*  
date well completed firm name county well located

LANDOWNER: *Charles Miller*  
*P.O. Box 340,*  
*Pascagoula Miss.*  
(mailing address) *39567*

WELL LOCATION:  
sec. *33* T. *6* N. R. *7* E  
*4* miles *S* of *Vandevore*  
(distance) (direction) (nearest town)

WELL PURPOSE: *None*  
(home, irrigation, municipal, industrial)

WELL COMPLETION DATA:

(1) diameter (inches) *2"*

(2) total depth (feet) *369'*

(3) static water level (feet) *60* below above  
top of ground.

(4) casing *PVC* *359'*  
(material) (depth)  
*2"*  
(size) if telescope see back.

(5) screen *10'* *359'*  
(length) (depth to top)

(6) pump *8-* *PVC*  
(HP) (yield gpm)  
*Elect.*  
(type power)

(7) electric log *No-*  
(yes or no)  
*(organization running log)*

(8) how well bottom plugged  
*Back Wash Valve*

Description of formations encountered	from	to
<i>Top Soil</i>	<i>0</i>	<i>2'</i>
<i>Red Clay</i>	<i>2'</i>	<i>22'</i>
<i>Blue Clay</i>	<i>22'</i>	<i>152'</i>
<i>Gray Coarse Sand</i>	<i>152'</i>	<i>190'</i>
<i>Blue Clay</i>	<i>190'</i>	<i>280'</i>
<i>Gray Coarse Sand</i>	<i>280'</i>	<i>311'</i>
<i>Blue Clay</i>	<i>311'</i>	<i>359'</i>
<i>Gray Med. Sand</i>	<i>359'</i>	<i>369'</i>

DEPT. OF NATURAL RESOURCES  
BUREAU OF LAND & WATER RESOURCES


11:00 AM 9:15 1981

RECEIVED

DRILLERS REMARKS:

If well telescopes please sketch and show depths.

GROUND LEVEL

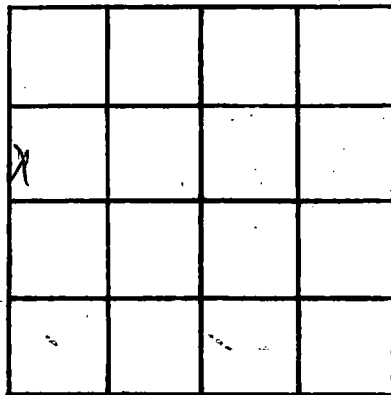

SECTION 33

Please indicate well location X.

ADDITIONAL INFORMATION

If more than one screen, show locations of each on sketch.