

MISSISSIPPI DEPARTMENT OF NATURAL RESOURCES

Bureau of Land and Water Resources

Southport Mall

P.O. Box 10631

Jackson, Mississippi 39209

WATER WELL DRILLERS LOG

JACKSON
K 2117
10-21-81

10-21-81 date well completed
Cross Water Well Sew. firm name
Jackson county, well located

LANDOWNER: Vanclave Masonic Lodge

Vanclave,
Miss 39564
(mailing address)

WELL LOCATION:
sec. 9 T. 6 N. R. 7 E
10 miles (distance) of VANCLAVE (direction) of (nearest town)

WELL PURPOSE:
(home, irrigation, municipal, industrial)

WELL COMPLETION DATA:
(1) diameter (inches) 2"
(2) total depth (feet) 260'
(3) static water level (feet) 36' below top of ground
(4) casing PVC 250' (material) (depth)
2" (size) if telescope see back.
(5) screen 10' 250 (length) (depth to top)
2" (size) PVC (material)
(6) pump 1 (HP) 9 (yield gpm)
ELECT (type power)
(7) electric log No (yes or no)
(organization running log)

(8) how well bottom plugged
Back Wash Valve

description of formations encountered	from	to
<u>Top soil</u>	<u>0</u>	<u>10'</u>
<u>Red Coarse sand & wood</u>	<u>10'</u>	<u>30'</u>
<u>Blue Clay</u>	<u>30'</u>	<u>50'</u>
<u>Red Coarse sand</u>	<u>50'</u>	<u>107'</u>
<u>Blue Clay</u>	<u>107'</u>	<u>215'</u>
<u>Blue Clay & streak of sand</u>	<u>215'</u>	<u>241'</u>
<u>Gray Coarse sand</u>	<u>241'</u>	<u>260'</u>

DEPT. OF NATURAL RESOURCES
BUREAU OF LAND & WATER RESOURCES


NOV 18 1981

RECEIVED

DRILLERS REMARKS:

If well telescopes please sketch and show depths.

GROUND LEVEL

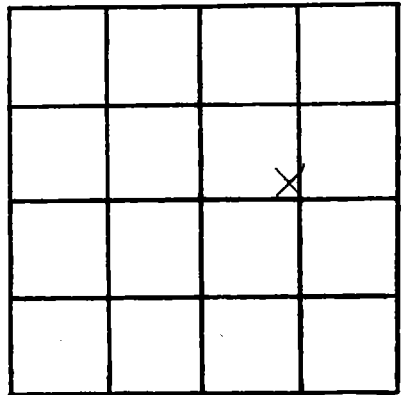

SECTION 9

Please indicate well location X.

ADDITIONAL INFORMATION

If more than one screen, show locations of each on sketch.