

MISSISSIPPI DEPARTMENT OF NATURAL RESOURCES

Bureau of Land and Water Resources

Southport Mall

P.O. Box 10631

Jackson, Mississippi 39209

WATER WELL DRILLERS LOG

JACKSON  
K 2190  
10/21/81

10/21/81 19 Lyman Well Co. Jackson  
date well completed firm name county well located

LANDOWNER David Spence  
11608 Forrest Crest  
Vandave 39564  
(mailing address)

description of formations encountered	from	to
Red Sand & Clay	0	60
Gray Clay	60	140
Blue Clay	140	230
Blue Clay & Sand	230	280
Blue Clay	280	310
good SAND	310	366

WELL LOCATION:  
sec. 8 T. 6 N. R. 7 E  
2 miles S/W of Vandave  
(distance) (direction) (nearest town)

WELL PURPOSE: Home  
(home, irrigation, municipal, industrial)

WELL COMPLETION DATA:

(1) diameter (inches) 2

(2) total depth (feet) 366

(3) static water level (feet) 75 below above top of ground.

(4) casing PVC, 356  
(material) (depth)  
2 If telescope see back.  
(size)

(5) screen 10, 356  
(length) (depth to top)  
2 PVC  
(size) (material)

(6) pump 1 12  
(HP) (yield gpm)  
electric  
(type power)

(7) electric log No  
(yes or no)  
NO  
(organization running log)

(8) how well bottom plugged sand  
seal

DEPT. OF NATURAL RESOURCES  
BUREAU OF LAND & WATER RESOURCES


OCT 20 1981

RECEIVED

DRILLERS REMARKS:

If well telescopes please sketch and show depths.

GROUND LEVEL

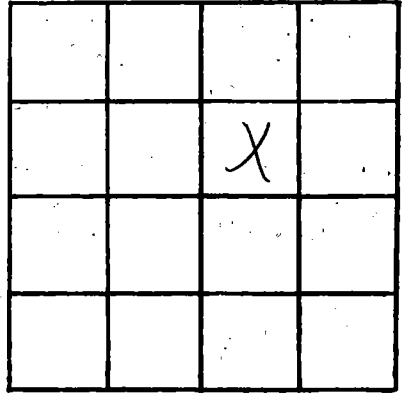

SECTION   f  

Please indicate well location X.

ADDITIONAL INFORMATION

If more than one screen,  
show locations of each on sketch.