

MISSISSIPPI DEPARTMENT OF NATURAL RESOURCES

Bureau of Land and Water Resources

Southport Mall

P.O. Box 10631

Jackson, Mississippi 39209

WATER WELL DRILLERS LOG

K2121

12-3-81 19 Coal Water Well Sew. Jackson
 date well completed firm name county well located

LANDOWNER: Fred Herrell
Rt 4 - Box 205
Ocean Springs, Miss.
 (mailing address) 39164

description of formations encountered	from	to
<u>Top soil</u>	<u>0</u>	<u>3'</u>
<u>L. Clay</u>	<u>3'</u>	<u>10'</u>
<u>S. Sand</u>	<u>10'</u>	<u>30'</u>
<u>L. Clay</u>	<u>30'</u>	<u>55'</u>
<u>S. sand</u>	<u>55'</u>	<u>69'</u>

WELL LOCATION:
 sec. 24 T. 6 N. R. 7 E. S. 5 W. 4
4 miles SE of VAN CLEAVE
 (distance) (direction) (nearest town)

WELL PURPOSE: Home
 (home, irrigation, municipal, industrial)

- WELL COMPLETION DATA:
- (1) diameter (inches) 2"
 - (2) total depth (feet) 69'
 - (3) static water level (feet) 25' ^{below} _{above} top of ground.
 - (4) casing PVC 59'
 (material) (depth)
2" If telescope see back.
 (size)
 - (5) screen 10' 59'
 (length) (depth to top)
2" PVC
 (size) (material)
 - (6) pump 1/2 hp 6-
 (HP) (yield gpm)
Elect
 (type power)
 - (7) electric log No.
 (yes or no)
 (organization running log)
 - (8) how well bottom plugged back wash valve

DRILLERS REMARKS:


DEPT. OF NATURAL RESOURCES
 BUREAU OF LAND & WATER RESOURCES

JAN 26 1982

RECEIVED

If well telescopes please sketch and show depths.

GROUND LEVEL

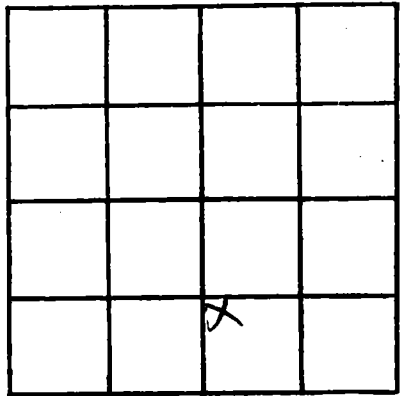

SECTION 24

Please indicate well location X.

ADDITIONAL INFORMATION

If more than one screen,
show locations of each on sketch.