

MISSISSIPPI DEPARTMENT OF NATURAL RESOURCES

Bureau of Land and Water Resources

Southport Mall

P.O. Box 10631

Jackson, Mississippi 39209

WATER WELL DRILLERS LOG

Jackson
K 2192

2-20-1982 date well completed 82 Coast Water Well Serv. firm name Jackson county well located

LANDOWNER: John Henderson
Rt 76 Box 242 V
Ocean Springs, Miss.
(mailing address)

description of formations encountered	from	to
Top soil	0	3'
Red Clay	3'	10'
Red Coarse sand	10'	61'
Blue Clay	61'	236'
Gray Coarse sand	236'	260'

WELL LOCATION:
sec. 24 T 6 S R 7 E
4 miles SE of VANCELAKE
(distance) (direction) (nearest town)

WELL PURPOSE: Home
(home, irrigation, municipal, industrial)

WELL COMPLETION DATA:

(1) diameter (inches) 2"

(2) total depth (feet) 260'

(3) static water level (feet) 40' ^{below} ~~above~~ top of ground.

(4) casing PVC, 250' (material) (depth)
2" (size) if telescope see back.

(5) screen 10' 250' (length) (depth to top)
2" PVC (size) (material)

(6) pump 1 -9- (HP) (yield gpm)
Elect. (type power)

(7) electric log No. (yes or no)

(organization running log)

(8) how well bottom plugged
Back Wash Valve

DRILLERS REMARKS:


DEPT. OF NATURAL RESOURCES
BUREAU OF LAND & WATER RESOURCES

MAR 11 1982

RECEIVED

If well telescopes please sketch and show depths.

GROUND LEVEL

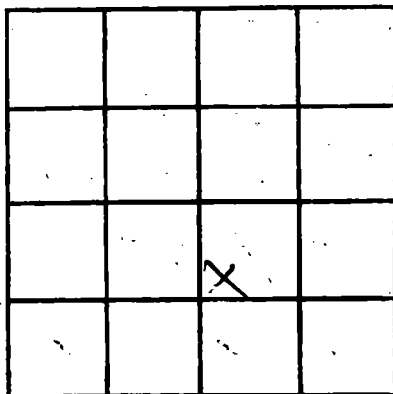

SECTION 24

Please indicate well location X.

ADDITIONAL INFORMATION

If more than one screen, show locations of each on sketch.