

MISSISSIPPI DEPARTMENT OF NATURAL RESOURCES

Bureau of Land and Water Resources

Southport Mall

P.O. Box 10631

Jackson, Mississippi 39209

WATER WELL DRILLERS LOG

Jackson
RH
2126

5-31
date well completed

1982 Coast Water Well Dr.
firm name

Jackson
county well located

LANDOWNER:

Antonia Breyer
P.O. Box 1324
Pascagoula Miss.
(mailing address)

description of formations encountered

from to

<i>Top soil</i>	<i>0</i>	<i>4'</i>
<i>Red Clay</i>	<i>4</i>	<i>63'</i>
<i>Red coarse sand</i>	<i>63'</i>	<i>72'</i>
<i>Blue Clay</i>	<i>72'</i>	<i>108'</i>
<i>Gray Coarse</i>	<i>108</i>	<i>124'</i>

WELL LOCATION:

sec *29 T 6 S R 7 E*
3 miles *5* of *Pandora*
(distance) (direction) (nearest town)

WELL PURPOSE:

Home
(home, irrigation, municipal, industrial)

WELL COMPLETION DATA:

- (1) diameter (inches) *4"*
- (2) total depth (feet) *124'*
- (3) static water level (feet) *57'* (below top of ground)
- (4) casing *PVC*, *114'*
(material), (depth)
4" (size) if telescope see back.
- (5) screen *10'*, *114'*
(length), (depth to top)
4" (size) *PVC* (material)
- (6) pump *1 1/2"*, *30*
(type), (yield gpm)
Electric (type power)
- (7) electric log *No.*
(yes or no)

(organization running log)

DEPT. OF NATURAL RESOURCES
BUREAU OF LAND & WATER RESOURCES

JUL 21 1982


RECEIVED

DRILLERS REMARKS:

(B) *How well bottom plugged?*
Back Wash Valve

If well telescopes please sketch and show depths.

GROUND LEVEL

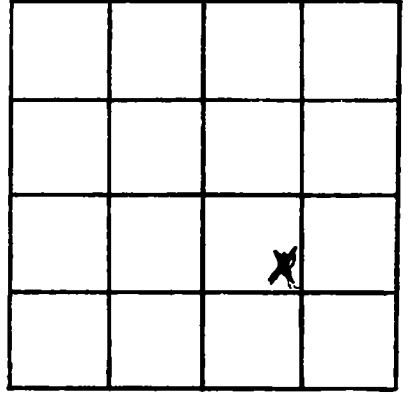

SECTION 29

Please indicate well location X.

ADDITIONAL INFORMATION

If more than one screen,
show locations of each on sketch.