

MISSISSIPPI DEPARTMENT OF NATURAL RESOURCES

Bureau of Land and Water Resources

Southport Mall

P.O. Box 10631

Jackson, Mississippi 39209

WATER WELL DRILLERS LOG

Jackson
K 2121

6-15-82 19 Coast Water Well Sew. Jackson
date well completed firm name county well located

LANDOWNER: Bruce Fisher
2515 Redwood Rd.
Ocean Springs, Miss
(mailing address) 39564

WELL LOCATION:
sec. 20 T. 6 N. R. 7 E
3 miles SSW of VANDLERG
(distance) (direction) (nearest town)

WELL PURPOSE:
(home, irrigation, municipal, industrial)

WELL COMPLETION DATA:
(1) diameter (inches) 2"
(2) total depth (feet) 375'
(3) static water level (feet) 76' below
top of ground.
(4) casing PVC, 365'
(material) (depth)
5" if telescope see back.
(size)
(5) screen 10', 365'
(length) (depth to top)
2" PVC
(size) (material)
(6) pump (HP) (yield gpm)
Eliot
(type power)
(7) electric log No.
(yes or no)
(organization running log)
(8) How well bottom plugged
Puck wash valve

description of formations encountered	from	to
Top soil	0	5'
Red Clay	5'	50'
Blue Clay	50'	65'
White Clay	65'	107'
Red Coarse sand	107'	195'
Blue Clay	195'	280'
Blue Clay & Sand	280'	323'
Gray Coarse sand	323'	375'

DEPT. OF NATURAL RESOURCES
BUREAU OF LAND & WATER RESOURCES


JUL 21 1982

RECEIVED

DRILLERS REMARKS:

If well telescopes please sketch and show depths.

GROUND LEVEL

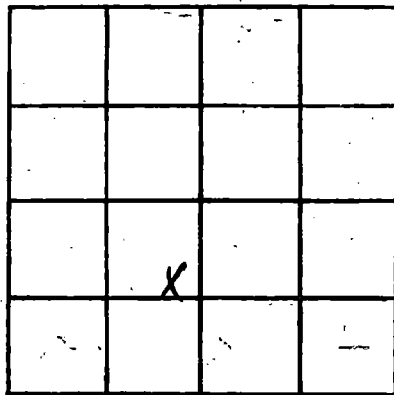

SECTION _____

Please indicate well location X.

ADDITIONAL INFORMATION

If more than one screen, show locations of each on sketch.