

MISSISSIPPI DEPARTMENT OF NATURAL RESOURCES

Bureau of Land and Water Resources

Southport Mall

P.O. Box 10631

Jackson, Mississippi 39209

WATER WELL DRILLERS LOG

Jackson
K 2128

6-16-82 19
date well completed

Coast Water Well Sew. Jackson
firm name county well located

LANDOWNER: Tony Ely
Rt 2 - Box 270
Ocean Springs, Miss.
(mailing address) 37564

description of formations encountered	from	to
Top soil	0	2'
R. Clay	2'	12'
G. clay	12'	43'
M. sand	43'	70'

WELL LOCATION:
sec. 9 T. 6 N R. 7 E
1/2 miles N of VAN CLEAVE
(distance) (direction) (nearest town)

WELL PURPOSE: Home
(home, irrigation, municipal, industrial)

WELL COMPLETION DATA:

(1) diameter (inches) 2"

(2) total depth (feet) 70'

(3) static water level (feet) 30' below top of ground

(4) casing PVC 60' (material) (depth)

(size) If telescope see back.

(5) screen 10' 60' (length) (depth to top)

(size) PVC (material)

(6) pump 1hp 8 (HP) (yield gpm)

Elect. (type power)

(7) electric log No- (yes or no)

(organization running log)

(8) How well bottom plugged Back wash valve

DEPT. OF NATURAL RESOURCES
BUREAU OF LAND & WATER RESOURCES


JUL 21 1982

RECEIVED

DRILLERS REMARKS:

If well telescopes please sketch and show depths.

GROUND LEVEL

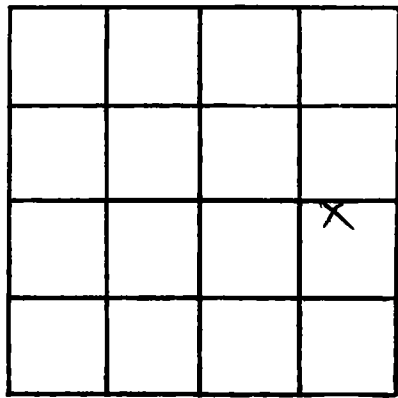

SECTION 9

Please Indicate well location X.

ADDITIONAL INFORMATION

A series of horizontal lines for writing additional information, starting below the 'ADDITIONAL INFORMATION' header and extending to the bottom of the page.

If more than one screen, show locations of each on sketch.