

MISSISSIPPI DEPARTMENT OF NATURAL RESOURCES

Bureau of Land and Water Resources

Southport Mall

P.O. Box 10631

Jackson, Mississippi 39209

WATER WELL DRILLERS LOG

Jackson  
K 2130

Aug 26 1982 Duncan Well Drilling Jackson  
date well completed firm name county well located

LANDOWNER: Judy Hillier  
310 Simon Blvd.  
Ocean Springs, Mo.  
(mailing address)

description of formations encountered	from	to
	Clay	0
Sand	25	140
Blue Clay	140	380
fine Sand	380	480
Course Sand	480	504

WELL LOCATION:  
sec. 8 T. 6 N. R. 7 W.  
4 miles W of Thandane  
(distance) (direction) (nearest town)

WELL PURPOSE: Home  
(home, irrigation, municipal, industrial)

- WELL COMPLETION DATA:
- (1) diameter (inches) 2"
  - (2) total depth (feet) 504
  - (3) static water level (feet) 33' below above top of ground.
  - (4) casing PVC, 494' (material) (depth)  
(size) If telescope see back.
  - (5) screen 10' 194' (length) (depth to top)  
2" PVC (size) (material)
  - (6) pump 1 (HP) 8 (yield gpm)  
electric (type power)
  - (7) electric log (yes or no)

(organization running log)  
(8) how well bottom plugged Sand

DRILLERS REMARKS: Over  
had his own pump & installed it.


DEPT. OF NATURAL RESOURCES  
BUREAU OF LAND & WATER RESOURCES

JAN 21 1988

RECEIVED

If well telescopes please sketch and show depths.

GROUND LEVEL

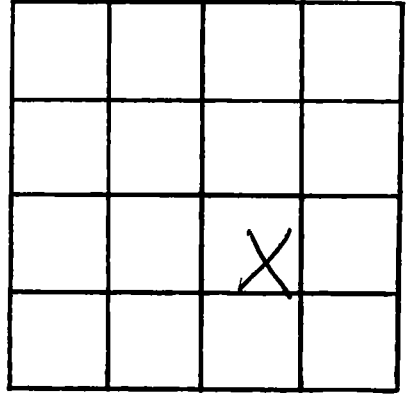

SECTION 2

Please indicate well location X.

ADDITIONAL INFORMATION

If more than one screen, show locations of each on sketch.