

MISSISSIPPI DEPARTMENT OF NATURAL RESOURCES

Bureau of Land and Water Resources

Southport Mall

P.O. Box 10631

Jackson, Mississippi 39209

WATER WELL DRILLERS LOG

Jackson
K2131

9-7-82
date well completed

19 Coast Water Well Sew.
firm name

Jackson
county well located

LANDOWNER:

Johnny Mae
Rt 46 Box 249
Ocean Springs, Miss.
(mailing address) 37564

description of formations encountered

from to

Top soil	0	3'
Red Clay	3'	22'
Blue Clay	22'	65'
Gray Clay	65'	76'
Red base sand	76'	146'

WELL LOCATION:

sec. 11 T. 6 N. R. 7 E
2 miles (distance) E of VANCELAKE (nearest town)

WELL PURPOSE:

Home
(home, irrigation, municipal, industrial)

WELL COMPLETION DATA:

- (1) diameter (inches) 2"
- (2) total depth (feet) 146'
- (3) static water level (feet) 57' below top of ground.
- (4) casing PVC, 136' (material) (depth)
2" (size) If telescope see back.
- (5) screen 40' (length), 136' (depth to top)
2" (size), PVC (material)
- (6) pump 1 hp. 8 (HP) (yield gpm)
Elect. (type power)
- (7) electric log No (yes or no)

(organization running log)

(8) how well bottom plugged
Back Wash Valve

DRILLERS REMARKS:


MISSISSIPPI DEPARTMENT OF NATURAL RESOURCES
BUREAU OF LAND & WATER RESOURCES

NOV 18 1982

RECEIVED

If well telescopes please sketch and show depths.

GROUND LEVEL

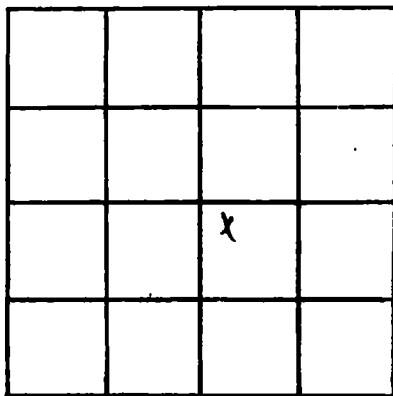

SECTION 11

Please indicate well location X.

ADDITIONAL INFORMATION

If more than one screen,
show locations of each on sketch.