

MISSISSIPPI DEPARTMENT OF NATURAL RESOURCES

Bureau of Land and Water Resources

Southport Mall

P.O. Box 10631

Jackson, Mississippi 39209

WATER WELL DRILLERS LOG

Jackson
K2132

9-13-82 date well completed
82 Coast Water Well Sew. firm name
Jackson county well located

LANDOWNER: Gary Butch Noble
P.O. Box 61-5 Quana Rd
Ocean Springs, Miss.
(mailing address) 32564

Description of formations encountered	from	to
Top soil	0	3'
Red Clay	3'	15'
purple Clay	15'	23'
Blue Clay	23'	80'
Reddish sand & silt of clay	80'	126'
Blue Clay	126'	289'
Gray Consolidated	289'	328'

WELL LOCATION:
sec. M T 6 N R. 7 W
1 miles SW of VAN CLEAVE
(distance) (direction) (nearest town)

WELL PURPOSE: Dom
(home, irrigation, municipal, industrial)

- WELL COMPLETION DATA:
- (1) diameter (inches) 2"
 - (2) total depth (feet) 328'
 - (3) static water level (feet) 55' (below top of ground)
 - (4) casing PVC, 318'
(material) (depth)
2" if telescope see back.
(size)
 - (5) screen 10', 318'
(length) (depth to top)
2", PVC
(size) (material)
 - (6) pump _____ (HP) _____ (yield gpm)
 - (7) electric log No.
(yes or no)
_____ (organization running log)

(8) How well bottom plugged?
pac wash. Valve

DRILLERS REMARKS:


DEPT. OF NATURAL RESOURCES
BUREAU OF LAND & WATER RESOURCES

NOV 18 1982

RECEIVED

If well telescopes please sketch and show depths.

GROUND LEVEL

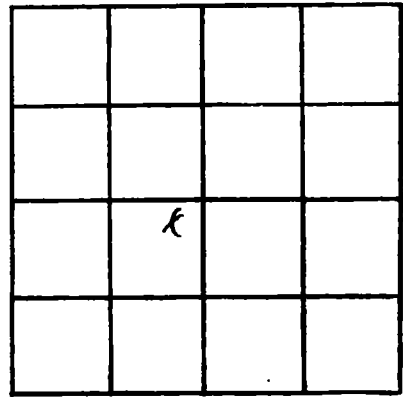

SECTION 17

Please indicate well location X.

ADDITIONAL INFORMATION

If more than one screen, show locations of each on sketch.