

MISSISSIPPI DEPARTMENT OF NATURAL RESOURCES

Bureau of Land and Water Resources

Southport Mall

P.O. Box 10631

Jackson, Mississippi 39209

WATER WELL DRILLERS LOG

Jackson
K2133

7-28-82 19 Coast Water Well Sew. Jackson
date well completed firm name county well located

LANDOWNER: Frederic Castelan

description of formations encountered

from to

Box 253 P.
Ocean Springs, Miss.
(mailing address) 0-3864

<u>Top soil</u>	<u>0</u>	<u>2'</u>
<u>R. Clay</u>	<u>2'</u>	<u>12'</u>
<u>M. Sand</u>	<u>12'</u>	<u>23'</u>
<u>S. Clay</u>	<u>23'</u>	<u>60'</u>
<u>M. Sand</u>	<u>60'</u>	<u>130'</u>

WELL LOCATION:

sec. 11 T. 6 R. 2
2 miles E of VAN CLEAVE
(distance) (direction) (nearest town)

WELL PURPOSE: Home
(home, irrigation, municipal, industrial)

WELL COMPLETION DATA:

- (1) diameter (inches) 2"
- (2) total depth (feet) 130'
- (3) static water level (feet) 42 (below) above top of ground
- (4) casing PVC (material), 120' (depth)
2" (size) if telescope see back.
- (5) screen 10' (length), 120' (depth to top)
2" (size), PVC (material)
- (6) pump (HP) (yield gpm)
- (type power)
- (7) electric log No (yes or no)
(organization running log)

DEPT. OF NATURAL RESOURCES
BUREAU OF LAND & WATER RESOURCES

NOV 18 1982


RECEIVED

(8) how well bottom plugged? fresh work value

DRILLERS REMARKS:

If well telescopes please sketch and show depths.

GROUND LEVEL

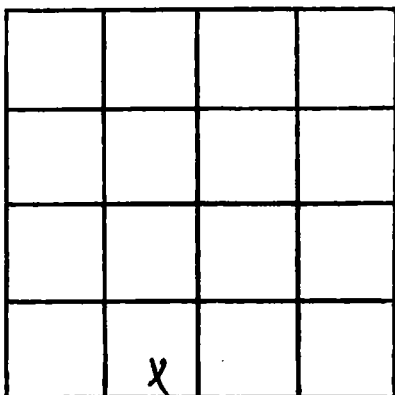

SECTION 11

Please indicate well location X.

ADDITIONAL INFORMATION

A series of horizontal lines for writing additional information.

If more than one screen, show locations of each on sketch.