

MISSISSIPPI DEPARTMENT OF NATURAL RESOURCES

Bureau of Land and Water Resources

Southport Mall

P.O. Box 10631

Jackson, Mississippi 39209

WATER WELL DRILLERS LOG

Jackson
K2137

11-3-82
date well completed

Coast Water Well Sew.

firm name

Jackson
county well located

LANDOWNER

Eddie Coleman

description of formations encountered

from

to

Vandeventer, Miss.

Sandy Top soil

0 17'

(mailing address)

W. clay

17' 33'

WELL LOCATION:

M. sand

33' 110'

sec 22 T 6 N R 7 E
2 miles SE of Vandeventer

WELL PURPOSE:

home
(home, irrigation, municipal, industrial)

WELL COMPLETION DATA:

- (1) diameter (inches) 2"
- (2) total depth (feet) 110'
- (3) static water level (feet) 32' below top of ground.
- (4) casing PUC, 100' (material) (depth)
- 2" (size) If telescope see back.
- (5) screen 10', 100' (length) (depth to top)
- 2" PUC (size) (material)
- (6) pump 1 hp, 9 1/2 (HP) (yield gpm)
- Elec. (type power)
- (7) electric log No. (yes or no)

(organization running log)

(8) how well bottom plugged
back wash valve

DRILLERS REMARKS:


DEPT. OF NATURAL RESOURCES
BUREAU OF LAND & WATER RESOURCES

DEC 31 1982

RECEIVED

If well telescopes please sketch and show depths.

GROUND LEVEL

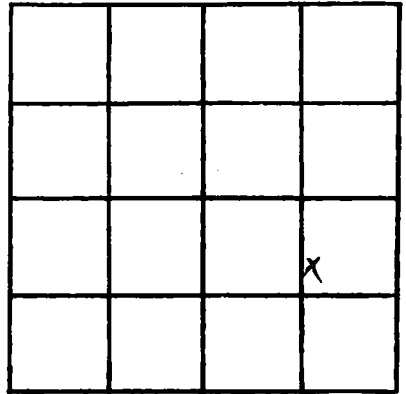

SECTION 22

Please indicate well location X.

ADDITIONAL INFORMATION

If more than one screen,
show locations of each on sketch.