

MISSISSIPPI DEPARTMENT OF NATURAL RESOURCES

Bureau of Land and Water Resources

Southport Mall

P.O. Box 10631

Jackson, Mississippi 39209

WATER WELL DRILLERS LOG

Jackson  
K 2138

12-3-82 19 Coast Water Well Serv. Jackson  
date well completed firm name county well located

LANDOWNER: Hester Mac Don  
Rt 2 - Box 271 - A.  
Ocean Springs, Miss  
(mailing address) 35164

| description of formations encountered | from | to   |
|---------------------------------------|------|------|
| Top soil                              | 0    | 2'   |
| Red Clay                              | 2'   | 18'  |
| Blue Clay                             | 18'  | 65'  |
| Red coarse sand                       | 65'  | 75'  |
| Blue Clay                             | 75'  | 215' |
| Blue Clay & streak of sand            | 215' | 241' |
| gray coarse sand                      | 241' | 275' |

WELL LOCATION:  
sec. 9 T. 6 S. R. 7 W.  
1N miles — of VAN CLEAVE  
(distance) (direction) (nearest town)

WELL PURPOSE: Home  
(home, irrigation, municipal, industrial)

- WELL COMPLETION DATA:
- (1) diameter (inches) 2"
  - (2) total depth (feet) 275'
  - (3) static water level (feet) 34' below above top of ground.
  - (4) casing PVC, 265'  
(material) (depth)  
2" if telescope see back.  
(size)
  - (5) screen 10', 265'  
(length) (depth to top)  
2" (size) PVC (material)
  - (6) pump 1 R.P., 9  
(HP) (yield gpm)  
Chlor. (type power)
  - (7) electric log No -  
(yes or no)  
— (organization running log)
  - (8) how well bottom plugged Back Wash Valve

DEPT. OF NATURAL RESOURCES  
BUREAU OF LAND & WATER RESOURCES


JAN 11 1983

RECEIVED

DRILLERS REMARKS:

If well telescopes please sketch and show depths.

GROUND LEVEL

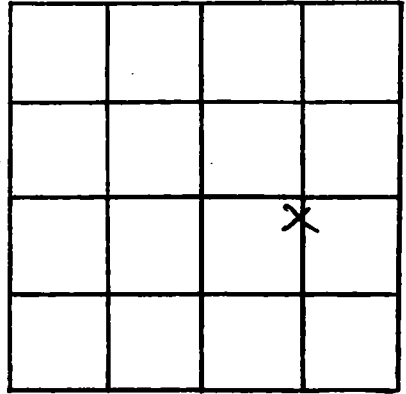

SECTION 9

Please indicate well location X.

ADDITIONAL INFORMATION

If more than one screen,  
show locations of each on sketch.