

MISSISSIPPI DEPARTMENT OF NATURAL RESOURCES

Bureau of Land and Water Resources

Southport Mall

P.O. Box 10631

Jackson, Mississippi 39209

WATER WELL DRILLERS LOG

Jackson  
K 2139

1-12-1983 date well completed  
23. Coast Water Well Sew. firm name  
Jackson county well located

LANDOWNER: Linda Stork  
P.O. Box 208,  
Ocean Springs, Miss.  
(mailing address)

description of formations encountered	from	to
Top soil	0	2'
Red Clay	2'	21'
Red Coarse sand & gravel	21'	57'
Blue Clay	57'	86'
Blue Clay & Steel of sand	86'	107'
Red Coarse sand & gravel	107'	133'
Blue Clay	133'	225'
Blue Clay & Steel of sand	225'	278'
Blue Clay	278'	323'
Gray fine sand	323'	341'
Gray Med sand	341'	362'
Gray Coarse sand	362'	384'

WELL LOCATION:  
sec. 23 T 6 S R 7 W  
3 miles SE of VANCELAVE  
(distance) (direction) (nearest town)

WELL PURPOSE: Home  
(home, irrigation, municipal, industrial)

WELL COMPLETION DATA:

(1) diameter (inches) 2"

(2) total depth (feet) 384'

(3) static water level (feet) 45' below top of ground

(4) casing PVC 374' (material) (depth)  
2" (size) if telescope see back.

(5) screen 10' 374' (length) (depth to top)  
2" (size) PVC (material)

(6) pump 1/2 HP 5 1/2 (type) (yield gpm)

(7) electric log No. (yes or no)  
(organization running log)

(8) how well bottom plugged? Backwash valve

DRILLERS REMARKS:


DEPT. OF NATURAL RESOURCES  
BUREAU OF LAND & WATER RESOURCES

FEB 18 1983

RECEIVED

If well telescopes please sketch and show depths.

GROUND LEVEL

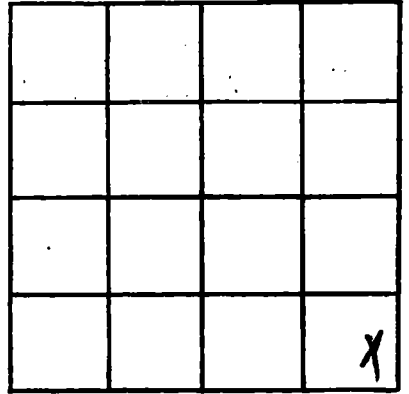

SECTION 23

Please indicate well location X.

ADDITIONAL INFORMATION

If more than one screen, show locations of each on sketch.