

MISSISSIPPI DEPARTMENT OF NATURAL RESOURCES

Bureau of Land and Water Resources

Southport Mall

P.O. Box 10631

Jackson, Mississippi 39209

WATER WELL DRILLERS LOG

Jackson
K 2170

3-24-83 19 1983 Coastal Water Well Sew. Jackson
date well completed firm name county well located

LANDOWNER	Description of formations encountered	from	to
<u>Ronald W. Murphy</u>	<u>Top soil</u>	<u>0</u>	<u>3'</u>
<u>Rt 4, Box 204 J.</u>	<u>Red Clay</u>	<u>3'</u>	<u>10'</u>
<u>Ocean Springs, Miss.</u>	<u>Red Coarse sand</u>	<u>10'</u>	<u>40'</u>
<u>(mailing address) 39564</u>	<u>Red Coarse sand & gravel</u>	<u>40'</u>	<u>67'</u>
	<u>Blue Clay</u>	<u>67'</u>	<u>234'</u>
	<u>gray Coarse sand</u>	<u>234'</u>	<u>260'</u>

WELL LOCATION:
sec 24 T 6 S R 7 E
3 1/2 miles ESE of VAN CLEAVE
(distance) (direction) (nearest town)

WELL PURPOSE: home
(home, irrigation, municipal, industrial)

WELL COMPLETION DATA:

- (1) diameter (inches) 2"
- (2) total depth (feet) 260'
- (3) static water level (feet) 41" below top of ground.
- (4) casing PVC 250'
(material) (depth)
2" If telescope see back.
(size)
- (5) screen 10' 250'
(length) (depth to top)
2" PVC
(size) (material)
- (6) pump 1 hp. 8 1/2
(HP) (yield gpm)
Electric
(type power)
- (7) electric log No.
(yes or no)

(organization running log)
- (8) back with valve
how well bottom plugged

DRILLERS REMARKS:


DEPT. OF NATURAL RESOURCES
BUREAU OF LAND & WATER RESOURCES

APR 28 1983

RECEIVED

If well telescopes please sketch and show depths.

GROUND LEVEL

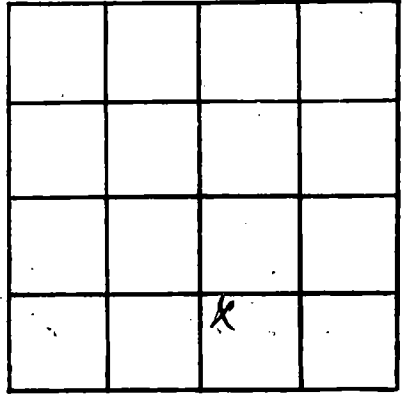

SECTION 24

Please indicate well location X.

ADDITIONAL INFORMATION

If more than one screen, show locations of each on sketch.