

MISSISSIPPI DEPARTMENT OF NATURAL RESOURCES

Bureau of Land and Water Resources

Southport Mall

P.O. Box 10631

Jackson, Mississippi 39209

WATER WELL DRILLERS LOG

*Jackson*  
*K 2141*

*2-9-83*  
date well completed

*Coast Water Well Sew.*  
firm name

*Jackson*  
county well located

LANDOWNER: *Curley Dunlap*  
*Vancleave, Miss.*  
*3264*  
(mailing address)

description of formations encountered	from	to
<i>B. Clay</i>	<i>0</i>	<i>10'</i>
<i>C. M. Sand</i>	<i>10'</i>	<i>80'</i>
<i>B. Clay</i>	<i>80'</i>	<i>238'</i>
<i>C. Sand</i>	<i>238'</i>	<i>264'</i>

WELL LOCATION:  
sec. *4* T. *6N* R. *7E*  
*IN* miles (distance) of *VANCLEAVE* (nearest town)

WELL PURPOSE: *None*  
(home, irrigation, municipal, industrial)

- WELL COMPLETION DATA:
- (1) diameter (inches) *2"*
  - (2) total depth (feet) *264'*
  - (3) static water level (feet) *36'* below top of ground.
  - (4) casing *PVC* *254'*  
(material) (depth)  
*2"* (size) If telescope see back.
  - (5) screen *10'* *254'*  
(length) (depth to top)  
*2"* (size) *PVC* (material)
  - (6) pump *1 1/2 HP* *10*  
(HP) (yield gpm)  
*Elect.* (type power)
  - (7) electric log *No.*  
(yes or no)
- (organization running log)

(8) how well bottom plugged  
*Backwash Valve*

DRILLERS REMARKS:


DEPT. OF NATURAL RESOURCES  
BUREAU OF LAND & WATER RESOURCES

APR 27 1983

RECEIVED

If well telescopes please sketch and show depths.

GROUND LEVEL

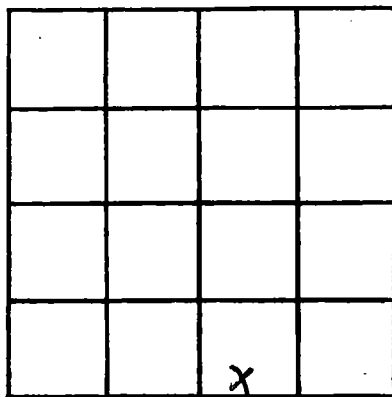

SECTION 4

Please indicate well location X.

ADDITIONAL INFORMATION

If more than one screen, show locations of each on sketch.