

MISSISSIPPI DEPARTMENT OF NATURAL RESOURCES

Bureau of Land and Water Resources

Southport Mall

P.O. Box 10631

Jackson, Mississippi 39209

WATER WELL DRILLERS LOG  
COASTAL DRILLING & SERVICE CO.

ROUTE 1 BOX 618

BILOXI, MISS. 39532

*Josbor*  
K2144

*Josbor*  
county well located

3548319

date well completed

LANDOWNER: *John Mohr*  
*Humphrey Jones*  
*Queen King Mrs*  
(mailing address)

description of formations encountered

from to

WELL LOCATION:  
sec. 19 T. 6 R. 7  
W S  
*Wane west Hwy 57*  
(distance) miles (direction) (nearest town)

<i>top soil</i>	1	3
<i>Red Clay</i>	3	15
<i>white sand</i>	15	60
<i>Soft Blue Clay</i>	60	120
<i>white sand</i>	120	180
<i>Soft Blue Clay</i>	180	305
<i>hard blue clay</i>	305	390
<i>fine water sand</i>	390	420
<i>good water sand</i>	420	445

WELL PURPOSE: *home*  
(home, irrigation, municipal, industrial)

WELL COMPLETION DATA:

(1) diameter (inches) 4 1/2"

(2) total depth (feet) 445'

(3) static water level (feet) 70' <sup>below</sup> ~~above~~ top of ground.

(4) casing 4 1/2" (material) 430' (depth)

4 1/2" (size) if telescope see back.

(5) screen 15' (length) 430' (depth to top)

2" (size) 4 1/2" (material)

(6) pump One (HP) 20 (yield gpm)

5hp (type power)

(7) electric log no (yes or no)

(organization running log)

(8) how well bottom plugged  
2" below valve  
DRILLERS REMARKS: 19-15

DEPT. OF NATURAL RESOURCES  
BUREAU OF LAND & WATER RESOURCES

AUG 15 1983

RECEIVED

If well telescopes please sketch and show depths.


GROUND LEVEL

200' - 4" P.C. Casing

230' - 2" P.C. Casing

15' - 2" P.C. Screen

2" backwash Valve  
19-8

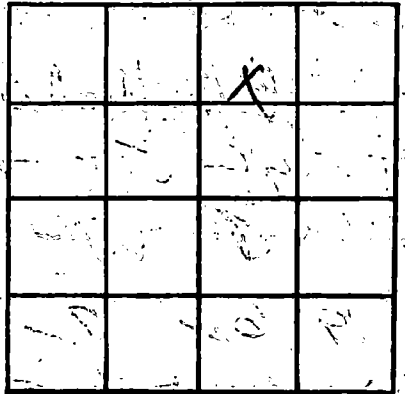

SECTION \_\_\_\_\_

Please indicate well location X.

ADDITIONAL INFORMATION

If more than one screen,  
show locations of each on sketch.