

MISSISSIPPI DEPARTMENT OF NATURAL RESOURCES
Bureau of Land and Water Resources
 Southport Mall
 P.O. Box 10631
 Jackson, Mississippi 39209
WATER WELL DRILLERS LOG

Jackson
K2148

June 6, 1983 Cochran Waterwell Service Jackson
 date well completed firm name county well located

LANDOWNER:
Earnest Bullock
Rt 8 Hattiesburg
 (mailing address)

description of formations encountered	from	to
	TOP Soil	0
brown clay	1	4
gray clay	4	12
sand	12	35
blue clay	35	80
sand	80	132

WELL LOCATION:
 sec. 13 T. 6 N. R. 7 E.
 (S) (W)
7 miles SE of Vandevue
 (distance) (direction) (nearest town)

WELL PURPOSE: home
 (home, irrigation, municipal, industrial)

WELL COMPLETION DATA:

(1) diameter (inches) 2"

(2) total depth (feet) 132'

(3) static water level (feet) 12 ^{below} _{above} top of ground.

(4) casing PVC, 132'
 (material) (depth)

2" If telescope see back.
 (size)

(5) screen 20', 132'
 (length) (depth to top)

2", PVC
 (size) (material)

(6) pump _____ (HP) _____ (yield gpm)
 (type power)

(7) electric log _____ (yes or no)
 (organization running log)


(8) how well bottom plugged valve

DRILLERS REMARKS:

DEPT. OF NATURAL RESOURCES
 BUREAU OF LAND & WATER RESOURCES
 SEP 13 1983
RECEIVED

If well telescopes please sketch and show depths.

GROUND LEVEL

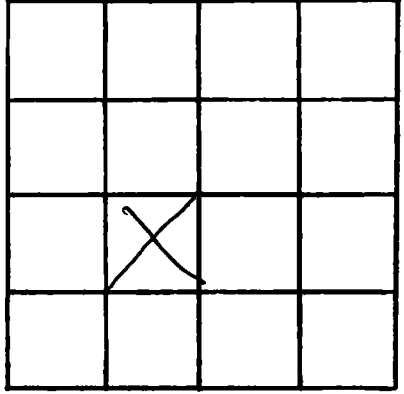

SECTION 13

Please indicate well location X.

ADDITIONAL INFORMATION

If more than one screen, show locations of each on sketch.