

Jackson
K 2149

MISSISSIPPI DEPARTMENT OF NATURAL RESOURCES
Bureau of Land and Water Resources
Southport Mall
P.O. Box 10631
Jackson, Mississippi 39209
WATER WELL DRILLERS LOG

6-13-83 date well completed
83 Coast Water Well Serv firm name
Jackson county well located

LANDOWNER: Christopher Graham
118 Jones Dr Rt 10
Biloxi, Miss 39232
(mailing address)

description of formations encountered	from	to
<u>0 sand</u>	<u>0</u>	<u>38'</u>
<u>B. Clay</u>	<u>38'</u>	<u>65'</u>
<u>M. C. Sand</u>	<u>65'</u>	<u>130'</u>

WELL LOCATION:
sec 35 T 6 S R 7 E
3 miles SE of VAN CLEAVE
(distance) (direction) (nearest town)

WELL PURPOSE: Home
(home, irrigation, municipal, industrial)

- WELL COMPLETION DATA:
- (1) diameter (inches) 2"
 - (2) total depth (feet) 130'
 - (3) static water level (feet) 18' ^{below} ~~above~~ top of ground.
 - (4) casing PVC 120'
(material) (depth)
2" if telescope see back.
(size)
 - (5) screen 10' 120'
(length) (depth to top)
2" PVC
(size) (material)
 - (6) pump 1 1/2 HP 7 1/2
(HP) (yield gpm)
Ches.
(type power)
 - (7) electric log No.
(yes or no)

(organization running log)

(8) Is well bottom plugged
Back wash valve

DRILLERS REMARKS:


DEPT. OF NATURAL RESOURCES
BUREAU OF LAND & WATER RESOURCES

SEP 21 1983

RECEIVED

If well telescopes please sketch and show depths.

GROUND LEVEL

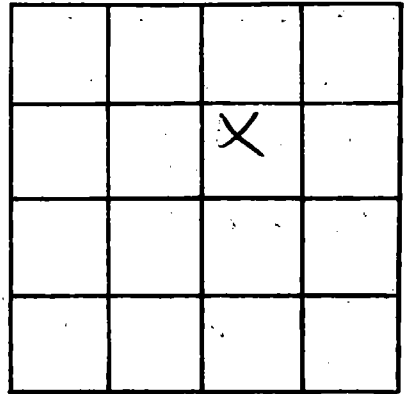

SECTION 35

Please indicate well location X.

ADDITIONAL INFORMATION

If more than one screen, show locations of each on sketch.