

MISSISSIPPI DEPARTMENT OF NATURAL RESOURCES

Bureau of Land and Water Resources

Southport Mall

P.O. Box 10631

Jackson, Mississippi 39209

WATER WELL DRILLERS LOG

Jackson
K2150

7-21-83 1983 Past Water Well Sew. Jackson
date well completed firm name county well located

LANDOWNER: Charles Edmonson
Kim Ramsey Rd.
Vicksburg, Miss.
(mailing address) 39564

WELL LOCATION:
sec 29 T 6 N R 7 W
2 miles (distance) S of Vincleaves (direction) (nearest town)

WELL PURPOSE: none
(home, irrigation, municipal, industrial)

WELL COMPLETION DATA:
(1) diameter (inches) 2"
(2) total depth (feet) 150'
(3) static water level (feet) 43' below top of ground.
(4) casing PVC, 140' (material) (depth)
2" (size) if telescope see back.
(5) screen 10' (length), 140' (depth to top)
2" (size) PVC (material)
(6) pump 1/2 HP, 8 (yield gpm)
check (type power)
(7) electric log No. (yes or no)
(organization running log)
(8) how well bottom plugged? sand wash valve

description of formations encountered	from	to
Top soil	0	1'
Red Clay	1	22'
Blue Clay	22'	42'
Red Coarse sand	42'	65'
Blue Clay	65'	88'
Gray Coarse sand	88'	150'

DEPT. OF NATURAL RESOURCES
BUREAU OF LAND & WATER RESOURCES


SEP 21 1983

RECEIVED

DRILLERS REMARKS:

If well telescopes please sketch and show depths.

GROUND LEVEL

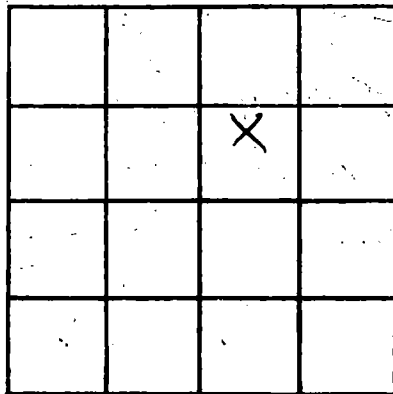

SECTION 29

Please indicate well location X.

ADDITIONAL INFORMATION

If more than one screen, show locations of each on sketch.