

MISSISSIPPI DEPARTMENT OF NATURAL RESOURCES

Bureau of Land and Water Resources

Southport Mall

P.O. Box 10631

Jackson, Mississippi 39209

WATER WELL DRILLERS LOG

Jackson
K2153

8-19
date well completed

1983 Jay Johnson
firm name

county well located

LANDOWNER: Dan Cole

Vancleave, MS
(mailing address)

WELL LOCATION:
sec. 29 T. 6 N. R. 7 E
5 miles E of VANCLEAVE
(distance) (direction) (nearest town)

description of formations encountered	from	to
TOP SOIL & SAND	0	20
CLAY	20	40
SAND	40	50
CLAY	50	80
SAND	80	90
CLAY	90	110
SAND	110	140
CLAY	140	240
SAND	240	265

WELL PURPOSE:
(home, irrigation, municipal, industrial)

WELL COMPLETION DATA:

(1) diameter (inches) 4"

(2) total depth (feet) 265'

(3) static water level (feet) 120 ^{below} top of ground

(4) casing PVC, 265'
(material) (depth)
4" (size) if telescope see back.

(5) screen 10', 255'
(length) (depth to top)
#8 (size) (material)

(6) pump 3/4, 15
(HP) (yield gpm)
(type power)

(7) electric log NO
(yes or no)
(organization running log)

(8) how well bottom plugged

DRILLERS REMARKS:


DEPT. OF NATURAL RESOURCES
BUREAU OF LAND & WATER RESOURCES

NOV - 7 1983

RECEIVED

If well telescopes please sketch and show depths.

GROUND LEVEL

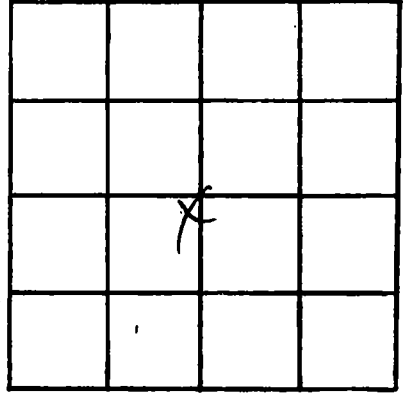

SECTION 5

Please indicate well location X.

ADDITIONAL INFORMATION

Lined area for additional information.

If more than one screen, show locations of each on sketch.