

MISSISSIPPI DEPARTMENT OF NATURAL RESOURCES

Bureau of Land and Water Resources

Southport Mall

P.O. Box 10631

Jackson, Mississippi 39209

WATER WELL DRILLERS LOG

Jackson
K 2154

10

9-3-83

FryFogle well service

JACKSON

date well completed

firm name

county well located

LANDOWNER: A.L. HARVEY
1008 LAKE AVE.
P.O. BOX 537
PASCAGOULA, MS. 39567
(mailing address)

description of formations encountered	from	to
BROWN CLAY	0	20
FINE SAND	20	40
Fine to coarse	40	60
Little coarse	60	80
sand to 95	80	95
clay	95	100
sand	100	110
clay	110	120
Fine sand	120	140
sand coarse	140	160
clay	160	180
clay	180	200
clay	200	220
sand - coarse	220	240
sand Real coarse	240	260
sand Real coarse	260	280

WELL LOCATION:
sec. 4 T 6 N R 7 E
3 miles N of PASCAGOULA
(distance) (direction) (nearest town)

WELL PURPOSE:
(home, irrigation, municipal, industrial)

WELL COMPLETION DATA:

- (1) diameter (inches) 4"
- (2) total depth (feet) 280'
- (3) static water level (feet) 3 below top of ground.
- (4) casing PVC (material), (depth) _____
_____ (size) if telescope see back.
- (5) screen 20' (length), 260 (depth to top)
1/2" (size), _____ (material)
- (6) pump 3/4 (HP), 10 (yld gpm)
(type power) _____
- (7) electric log (yes or no) _____
(organization running log) _____
- (8) how well bottom plugged _____

280
20
260

DEPT. OF NATURAL RESOURCES
BUREAU OF LAND & WATER RESOURCES


OCT 31 1983

RECEIVED

DRILLERS REMARKS:

If well telescopes please sketch and show depths.

GROUND LEVEL

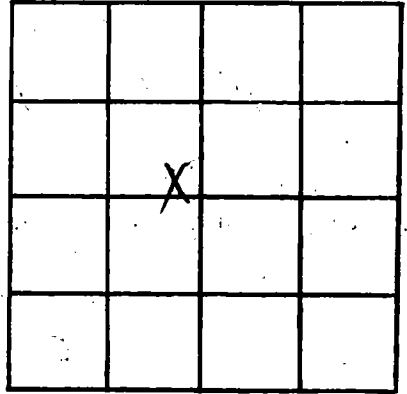

SECTION 5

Please indicate well location X.

ADDITIONAL INFORMATION

AC

If more than one screen, show locations of each on sketch.