

MISSISSIPPI DEPARTMENT OF NATURAL RESOURCES

Bureau of Land and Water Resources

Southport Mall

P.O. Box 10631

Jackson, Mississippi 39209

WATER WELL DRILLERS LOG

Jackson
K 2/55

9-15-83

19 *Coast Water Well Sew.*

Jackson

date well completed

firm name

county well located

LANDOWNER:

Charles F. Kimmsey

Box 222

Ocean Springs, Miss.
 (mailing address) *39564*

WELL LOCATION:

sec. *21* T. *6* S. R. *7* E.
1 miles *5* of *VANORANGE*
 (distance) (direction) (nearest town)

WELL PURPOSE:

(home, irrigation, municipal, industrial) *None*

WELL COMPLETION DATA:

- (1) diameter (inches) *2"*
- (2) total depth (feet) *115'*
- (3) static water level (feet) *32'* below ~~above~~ top of ground.
- (4) casing *PVC*, *105'*
 (material) (depth)
2" If telescope see back.
 (size)
- (5) screen *10'*, *105'*
 (length) (depth to top)
2" *PVC*
 (size) (material)
- (6) pump *1/2 P.*, *11*
 (HP) (field gpm)
Alert.
 (type power)
- (7) electric log *No.*
 (yes or no)
 (organization running log)

description of formations encountered

from

to

<i>Top soil</i>	<i>0</i>	<i>2'</i>
<i>Gray clay</i>	<i>2'</i>	<i>45'</i>
<i>Coarse sand</i>	<i>45'</i>	<i>115'</i>

(8) How well bottom plugged *backwash valve*

DRILLERS REMARKS:


DEPT. OF NATURAL RESOURCES
 BUREAU OF LAND & WATER RESOURCES

OCT 14 1983

RECEIVED

If well telescopes please sketch and show depths.

GROUND LEVEL

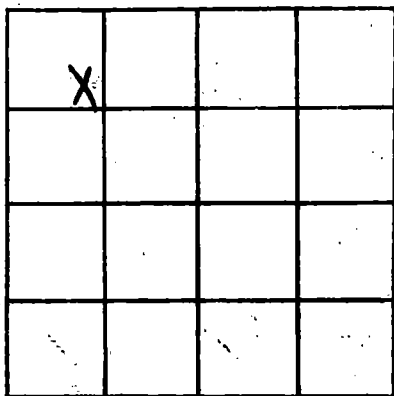

SECTION 21

Please indicate well location X.

ADDITIONAL INFORMATION

If more than one screen, show locations of each on sketch.