

**MISSISSIPPI DEPARTMENT OF NATURAL RESOURCES**  
**Bureau of Land and Water Resources**  
 Southport Mall  
 P.O. Box 10631  
 Jackson, Mississippi 39209  
**WATER WELL DRILLERS LOG**

Jackson  
K2157

11-16 1983 Ery Fogle well Jackson  
 date well completed file name county well located

**LANDOWNER:** H.L. HARVEY  
P.O. Box 537  
Vancleve, Ms. 39567  
 (mailing address)

**WELL LOCATION:**  
 sec. 5 T 6 N R 7 E  
 (S) (W)  
1 miles N of Vancleave  
 (distance) (direction) (nearest town)

**WELL PURPOSE:**  
 (home) irrigation, municipal, industrial

**WELL COMPLETION DATA:**

(1) diameter (inches) 2x4

(2) total depth (feet) 280'

(3) static water level (feet) 75 below above top of ground.

(4) casing PVC 280,  
 (material) (depth)  
4x2 if telescope see back. 1  
 (size)

(5) screen 20' 260  
 (length) (depth to top)  
1/8 PVC  
 (size) (material)

(6) pump 1/2 20  
 (HP) (yield gpm)  
elec  
 (type power)

(7) electric log yes or no  
 (organization running log)

(8) how well bottom plugged plc  
back

description of formations encountered	from	to
<u>Top Soil</u>	<u>0</u>	<u>3</u>
<u>sand</u>	<u>3</u>	<u>30</u>
<u>clay</u>	<u>30</u>	<u>50</u>
<u>clay</u>	<u>50</u>	<u>85</u>
<u>sand</u>	<u>85</u>	<u>110</u>
<u>clay</u>	<u>110</u>	<u>120</u>
<u>sand</u>	<u>120</u>	<u>180</u>
<u>clay</u>	<u>180</u>	<u>220</u>
<u>sand</u>	<u>220</u>	<u>245</u>
<u>clay</u>	<u>245</u>	<u>256</u>
<u>Good sand</u>	<u>256</u>	<u>280</u>

DEPT. OF NATURAL RESOURCES  
 BUREAU OF LAND & WATER RESOURCES

JAN 20 1984

**RECEIVED**

DRILLERS REMARKS: plc  
back

If well telescopes please sketch and show depths.


GROUND LEVEL

100' → 4"



160' → 2"

20' Screen

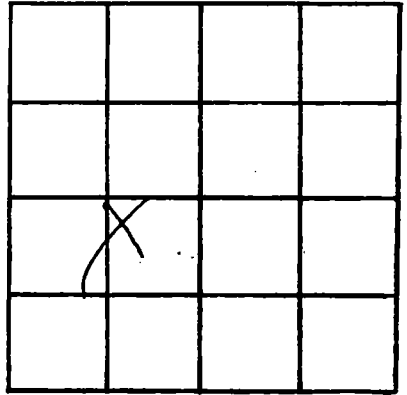

SECTION 5

Please indicate well location X.

ADDITIONAL INFORMATION

A series of horizontal lines providing space for additional information.

If more than one screen, show locations of each on sketch.