

MISSISSIPPI DEPARTMENT OF NATURAL RESOURCES

Bureau of Land and Water Resources

Southport Mall

P.O. Box 10631

Jackson, Mississippi 39209

WATER WELL DRILLERS LOG

Jackson
K2158

9-29-1983 date well completed
83 Carl Water Well Sew. firm name
Jackson county well located

South Central Well
LAND OWNER

Vancleave, Miss.

(mailing address) 39564

WELL LOCATION:

sec. 9 T. 6 N. R. 7 E. S. 1 W. 1
1 N miles (distance) of Vancleave (nearest town)
(direction)

WELL PURPOSE:

(home, irrigation, municipal, industrial)

WELL COMPLETION DATA:

- (1) diameter (inches) 2"
- (2) total depth (feet) 130'
- (3) static water level (feet) 51' below above top of ground.
- (4) casing PVC, 120' (material), (depth)
2" (size) if telescope see back.
- (5) screen 10' (length), 130' (depth to top)
2" (size), PVC (material)
- (6) pump 1/2 HP, 8 (yield gpm)
Mits. (type power)
- (7) electric log N. (yes or no)

(organization running log)

(8) how well bottom plugged
Back Wash Valve

description of formations encountered	from	to
Top soil	0	2'
Blue Clay	2'	64"
Red Mud. sand	64"	114'
Blue Clay	114'	130'

DEPT. OF NATURAL RESOURCES
BUREAU OF LAND & WATER RESOURCES


DEC 19 1983

RECEIVED

DRILLERS REMARKS:

If well telescopes please sketch and show depths.

GROUND LEVEL

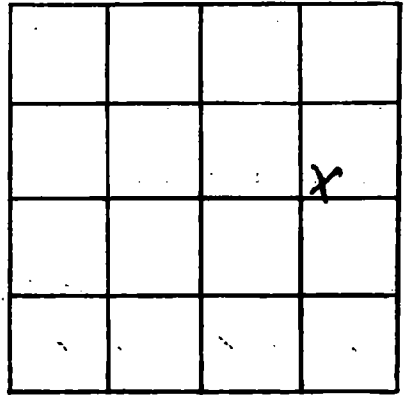

SECTION 9

Please indicate well location X.

ADDITIONAL INFORMATION

If more than one screen, show locations of each on sketch.