

MISSISSIPPI DEPARTMENT OF NATURAL RESOURCES

Bureau of Land and Water Resources

Southport Mall

P.O. Box 10631

Jackson, Mississippi 39209

WATER WELL DRILLERS LOG

Jackson
K2159

10-25-83
date well completed

Coast Water Well Sew.
firm name

Jackson
county well located

LANDOWNER: Bright Homes, Inc.
P.O. Box 1324
Lumberton, Miss.
(mailing address) 39567

WELL LOCATION:
sec 22 T 6 N R 7 E
2 1/4 miles SW of Vancleave
(distance) (direction) (nearest town)

WELL PURPOSE: home
(home, irrigation, municipal, industrial)

WELL COMPLETION DATA:
(1) diameter (inches) 2"
(2) total depth (feet) 273'
(3) static water level (feet) 36' (below top of ground)
(4) casing PVC 263' (material) (depth)
2" (size) If telescope see back.
(5) screen 10' 263' (length) (depth to top)
2" (size) PVC (material)
(6) pump 1 HP 10 (type) (yield gpm)
Elect. (type power)
(7) electric log No. (yes or no)
(organization running log)

description of formations encountered	from	to
Top soil	0	5'
Red Clay	5'	16'
Blue Clay	16'	60'
White Coarse sand & gravel	60'	108'
Blue Clay & gravel	108'	148'
Blue Clay & shuck off sand	148'	184'
White Coarse sand & wood	184'	194'
Blue Clay	194'	235'
Gray Coarse sand	235'	264'
Blue Clay	264'	273'

(8) how well bottom plugged
back wash valve

DRILLERS REMARKS:


DEPT. OF NATURAL RESOURCES
BUREAU OF LAND & WATER RESOURCES

DEC 10 1983

RECEIVED

If well telescopes please sketch and show depths.

GROUND LEVEL

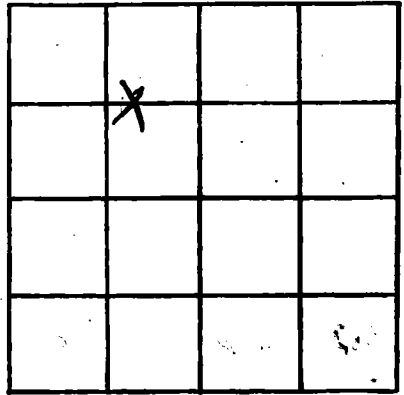

SECTION 29

Please indicate well location X.

ADDITIONAL INFORMATION

If more than one screen, show locations of each on sketch.