

MISSISSIPPI DEPARTMENT OF NATURAL RESOURCES

Bureau of Land and Water Resources

Southport Mall

P.O. Box 10631

16

Jackson, Mississippi 39209

WATER WELL DRILLERS LOG

Jackson
K2160

11-1-83

Coast Water Well Sew. Jackson

date well completed

firm name

county well located

LANDOWNER:

Richard Seal

description of formations encountered

from

to

Vancleave

Top soil

0 4'

Miss. 39564

(mailing address)

Red Clay

4' 40'

WELL LOCATION:

sec 19 T 6 S R 7 E
3 miles SW of VANCELAUE
(distance) (direction) (nearest town)

Red Clay & Shale / Blue Clay

40 80'

Blue Clay & Shale / Sand

80' 130'

Red coarse sand

130' 183'

WELL PURPOSE:

(home, irrigation, municipal, industrial)

Home

Blue Clay

183' 312'

WELL COMPLETION DATA:

(1) diameter (inches) 2"
(2) total depth (feet) 387'

Gray coarse sand

312' 382'

Blue Clay

382' 387'

(3) static water level (feet) 71' below top of ground

(4) casing PVC, 377' (material) (depth)

2" (size) If telescope see back.

(5) screen 10' (length), 377' (depth to top)

2" (size), PVC (material)

(6) pump 1 hp. 7 (HP) (yield gpm)

Electric (type power)

(7) electric log No. (yes or no)

(organization running log)

(8) how well bottom plugged Backwash Valve

DEPT. OF NATURAL RESOURCES
BUREAU OF LAND & WATER RESOURCES


MAR - 1 1984

RECEIVED

DRILLERS REMARKS:

If well telescopes please sketch and show depths.

GROUND LEVEL

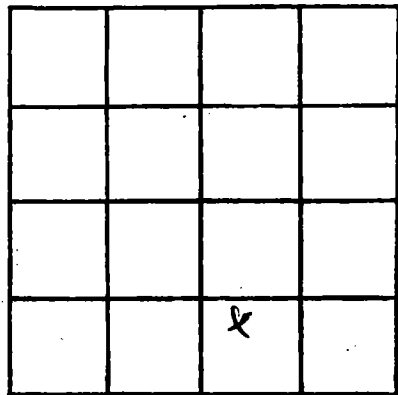

SECTION 19

Please indicate well location X.

ADDITIONAL INFORMATION

If more than one screen, show locations of each on sketch.