

MISSISSIPPI DEPARTMENT OF NATURAL RESOURCES

Bureau of Land and Water Resources

Southport Mall

P.O. Box 10631

Jackson, Mississippi 39209

WATER WELL DRILLERS LOG

Jackson
K 2163

12-12-83 date well completed
Coast Water Well Sew. firm name
Jackson county well located

LANDOWNER:

H. P. Shaver

description of formations encountered

from to

8516 Seaman Rd.

Top soil

0' 3'

Ocean Springs Miss.
(mailing address) 39564

Red clay

3' 10'

WELL LOCATION:

sec. 17 T. 6 S. R. 7 E.
2 miles SW of VANCELAVE
(distance) (direction) (nearest town)

Blue clay

10' 70'

Red med. sand

70' 130'

WELL PURPOSE:

(home, irrigation, municipal, industrial)

Home

Red med sand & gravel

130' 173'

WELL COMPLETION DATA:

(1) diameter (inches) 2"

Blue clay

173' 260'

(2) total depth (feet) 322

Gray coarse sand

260' 316'

(3) static water level (feet) 56' (below top of ground)

Blue clay

316' 322'

(4) casing PVC 312' (material) (depth)

Includes 10' Tail Pipe

2" (size) If telescope see back.

(5) screen 10' 312' (length) (depth to top)

2" PVC (size) (material)

(6) pump 1/2 HP 8 (type power) (yield gpm)

elect. (type power)

(7) electric log No. (yes or no)

(organization running log)

(8) how well bottom plugged Backwash valve

DEPT. OF NATURAL RESOURCES
BUREAU OF LAND & WATER RESOURCES


MAR - 1 1984

RECEIVED

DRILLERS REMARKS:

If well telescopes please sketch and show depths.

GROUND LEVEL

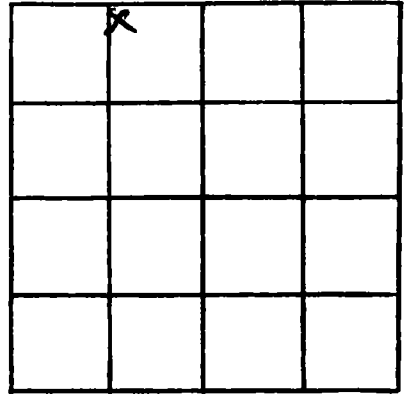

SECTION 17

Please indicate well location X.

ADDITIONAL INFORMATION

If more than one screen, show locations of each on sketch.