

MISSISSIPPI DEPARTMENT OF NATURAL RESOURCES

Bureau of Land and Water Resources

Southport Mall

P.O. Box 10631

Jackson, Mississippi 39209

WATER WELL DRILLERS LOG

Jackson
K 2164

2-14-84 19 Coast Water Well Co. Jackson
date well completed firm name county well located

Landowner: Dr. Steven K. Miles

Vanclave, Missi.
Vanclave Pentagon
(mailing address)

WELL LOCATION:

sec 16 T-6 S R 7 W
1 N miles — of VANCLAVE
(distance) (direction) (nearest town)

WELL PURPOSE:

Home
(home, irrigation, municipal, industrial)

WELL COMPLETION DATA:

- (1) diameter (inches) 2"
- (2) total depth (feet) 200'
- (3) static water level (feet) 42' below top of ground.
- (4) casing PVC, 190' (material) (depth)
2" (size) if telescope see back.
- (5) screen 10', 190' (length) (depth to top)
2" (size) PVC (material)
- (6) pump 1 hp, 9 (HP) (yield gpm)
Elect. (type power)
- (7) electric log No. (yes or no)

(organization running log)

(8) how well bottom plugged Back wash valve

description of formations encountered	from	to
Top soil	0	6'
Red Clay	6'	19'
Red Clay & Sand	19'	27'
Red Clay	27'	80'
Red Coarse sand & gravel	80'	108'
Blue Clay	108'	172'
Grey Coarse sand	172'	190'
Blue Clay	190'	200'
10' Tail Pipe		

DEPT. OF NATURAL RESOURCES
BUREAU OF LAND & WATER RESOURCES


APR 30 1984

RECEIVED

DRILLERS REMARKS:

If well telescopes please sketch and show depths.

GROUND LEVEL

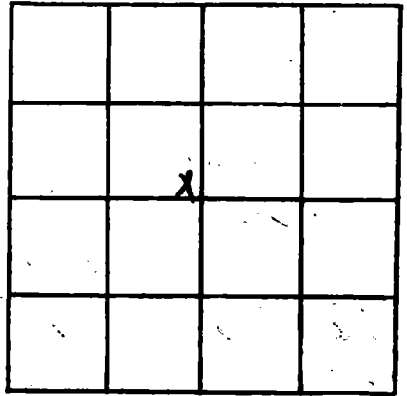

SECTION 16

Please indicate well location X.

ADDITIONAL INFORMATION

A series of horizontal lines for writing additional information, starting below the 'ADDITIONAL INFORMATION' header and extending to the bottom of the page.

RECEIVED
WATER RESOURCES
DIVISION
NOV 10 1967

If more than one screen, show locations of on sketch.