

MISSISSIPPI DEPARTMENT OF NATURAL RESOURCES

Bureau of Land and Water Resources

Southport Mall

P.O. Box 10631

Jackson, Mississippi 39209

WATER WELL DRILLERS LOG

Jackson
K 2166

5 // 19 84 Fryfogle Water Well Jackson
date well completed firm name county well located

LANDOWNER: <u>(H.L. Harvey) Griffin</u>	description of formations encountered	from	to
<u>Vanderve, ms</u> (mailing address)	Topsoil + clay	0	20
	SAND	20	60
	Clay	60	65
	SAND	65	75
	Clay	75	90
	SAND	90	130
	Clay	130	173
	SAND	133	150
	Clay	150	240
	SAND	240	250
WELL LOCATION:			
sec. <u>14</u> T- <u>6</u> N R- <u>7</u> E			
<u>5</u> miles <u>EAST</u> of <u>VANDEAUVE</u>			
(distance) (direction) (nearest town)			
WELL PURPOSE: <u>Home</u>			
(home, irrigation, municipal, industrial)			
WELL COMPLETION DATA:			
(1) diameter (inches) <u>4" x 2"</u>			
(2) total depth (feet) <u>250</u>			
(3) static water level (feet) <u>75'</u> ^{below} above top of ground.			
(4) casing <u>PVC</u> , <u>250'</u>			
(material) (depth)			
<u>4x2</u> If telescope see back.			
(size)			
(5) screen <u>10'</u> , <u>240</u>			
(length) (depth to top)			
<u>#6</u> , <u>PVC</u>			
(size) (material)			
(6) pump <u>1/2</u> , <u>10</u>			
(HP) (yield gpm)			
<u>elec</u>			
(type power)			
(7) electric log <u>NO</u>			
(yes or no)			
(organization running log)			
(8) how well bottom plugged <u>good</u>			
DRILLERS REMARKS:			


DEPT. OF NATURAL RESOURCES
BUREAU OF LAND & WATER RESOURCES

JUN 23 1984

RECEIVED

If well telescopes please sketch and show depths.

GROUND LEVEL

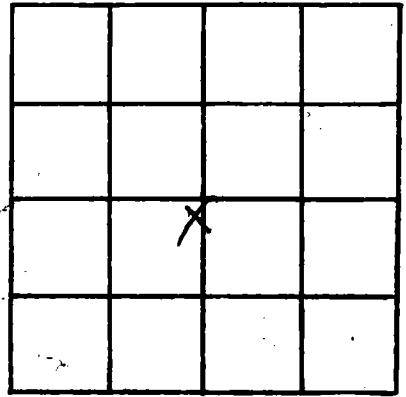

SECTION 5

Please indicate well location X.

ADDITIONAL INFORMATION

If more than one screen, show locations of each on sketch.