

MISSISSIPPI DEPARTMENT OF NATURAL RESOURCES

Bureau of Land and Water Resources

Southport Mall

P.O. Box 10631

Jackson, Mississippi 39209

WATER WELL DRILLERS LOG

Jackson
K 2169

7-13-84 19
date well completed

Coast Water Well Sew. Jackson
firm name county well located

LANDOWNER: Ruby Goff.
P.O. Box 254
Ocean Springs, Miss.
(mailing address) 37564

description of formations encountered	from	to
Red Clay	0	10'
Blue Clay	10'	45'
Blue Clay & Ship Sand	45'	90'
White sand	90'	140'
10'-2" Tail Pipe		

WELL LOCATION:

sec. 11 T. 6 N. R. 7 E
2 miles EAST VANCLAVE
(distance) (direction) (nearest town)

WELL PURPOSE: Home
(home, irrigation, municipal, industrial)

WELL COMPLETION DATA:

- (1) diameter (inches) 2"
- (2) total depth (feet) 140'
- (3) static water level (feet) 35' below top of ground.
- (4) casing PVC, 130' (material), (depth)
- 2" (size) If telescope see back.
- (5) screen 10' (length), 130' (depth to top)
- 2" PVC (size), (material)
- (6) pump (HP) (yield gpm)
- (type power)
- (7) electric log No (yes or no)
- (organization running log)

(8) how well bottom plugged
Backwash Valve


DRILLERS REMARKS:

DEPT. OF NATURAL RESOURCES
BUREAU OF LAND & WATER RESOURCES

OCT 11 1984
RECEIVED

If well telescopes please sketch and show depths.

GROUND LEVEL

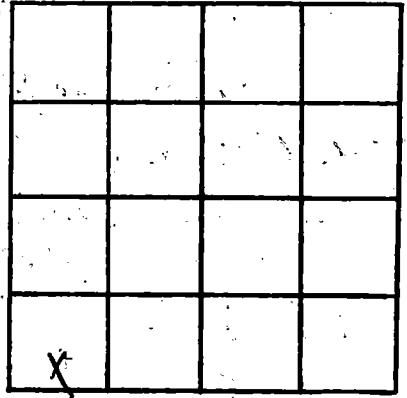

SECTION 11

Please indicate well location X.

ADDITIONAL INFORMATION

If more than one screen, show locations of each on sketch.