

# MISSISSIPPI DEPARTMENT OF NATURAL RESOURCES

Bureau of Land and Water Resources

Southport Mall

P.O. Box 10631

Jackson, Mississippi 39209

## WATER WELL DRILLERS LOG

Jackson  
K2191

8-14-84

Cross & Water Well Saw.

Jackson

date well completed

firm name

county well located

### LANDOWNER:

Picky Sharp  
5800 Woodch Acres Rd.

### description of formations encountered

from

to

Ocean Springs, Miss.  
(mailing address) 32564

Sandy Top soil

0 3'

Gray Clay

3' 90'

Med. Sand

90' 120'

Gray Clay

110' 120'

Coarse sand

120' 197'

Blue Clay

197' 310'

### WELL LOCATION:

sec 20 T 6 S

R 7 W

2 1/2 miles

5 (direction)

of VANLEAVE (nearest town)

### WELL PURPOSE:

(home, irrigation, municipal, industrial)

Home

Med. F. Sand

310' 320'

### WELL COMPLETION DATA:

(1) diameter (inches)

2"

(2) total depth (feet)

370'

(3) static water level (feet)

75' below above top of ground.

(4) casing

PVC (material)

360 (depth)

5" (size)

if telescope see back.

(5) screen

10' (length)

360' (depth to top)

2" (size)

PVC (material)

(6) pump

1 hp. (hp)

4 (yield gpm)

elect. (type power)

(7) electric log

No - (yes or no)

(organization running log)

(8) how well bottom plugged


Backwash valve

DRILLERS REMARKS:

RECEIVED  
OCT 12 1984  
DEPT. OF NATURAL RESOURCES  
BUREAU OF LAND & WATER RESOURCES

If well telescopes please  
sketch and show depths.

GROUND LEVEL

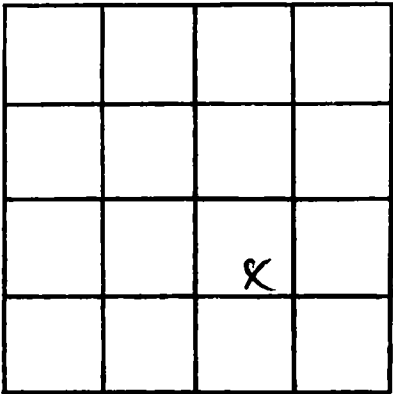

SECTION 20

Please indicate well location X.

ADDITIONAL INFORMATION

If more than one screen,  
show locations of each on sketch.