

MISSISSIPPI DEPARTMENT OF NATURAL RESOURCES

Bureau of Land and Water Resources

Southport Mall

P.O. Box 10631

Jackson, Mississippi 39209

WATER WELL DRILLERS LOG

Jackson
K2172

8-17-84 19 Coast & Water Well Sew. Jackson
date well completed firm name county well located

LANDOWNER Delton Pennell
Rt 4 - Box 249 E.
Clear Springs, Miss.
(mailing address) 3754

description of formations encountered	from	to
<u>Top soil</u>	<u>0</u>	<u>3'</u>
<u>Red Clay</u>	<u>3'</u>	<u>20'</u>
<u>Coarse sand</u>	<u>20'</u>	<u>32'</u>
<u>Gray Clay</u>	<u>32'</u>	<u>83'</u>
<u>Med. sand</u>	<u>83'</u>	<u>94'</u>
<u>White Clay</u>	<u>94'</u>	<u>105'</u>
<u>Med sand</u>	<u>105'</u>	<u>145'</u>

WELL LOCATION:
sec. 11 T. 6 N. R. 7 E.
2 1/2 miles EAST of Vanclave
(distance) (direction) (nearest town)

WELL PURPOSE: Home
(home, irrigation, municipal, industrial)

WELL COMPLETION DATA:

(1) diameter (inches) 2"

(2) total depth (feet) 145'

(3) static water level (feet) 50' below top of ground. above

(4) casing PVC 135'
(material) (depth)

2" If telescope see back.
(size)

(5) screen 10' 135'
(length) (depth to top)

2" PVC
(size) (material)

(6) pump 1/2 HP 8
(HP) (yield gpm)

Elect.
(type power)

(7) electric log No
(yes or no)

(organization running log)


(8) how well bottom plugged Back wash valve

DRILLERS REMARKS:

REPT. OF NATURAL RESOURCES
BUREAU OF LAND & WATER RESOURCES
OCT 16 1984
RECEIVED

If well telescopes please sketch and show depths.

GROUND LEVEL

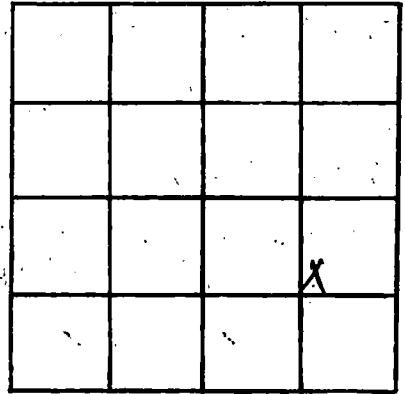

SECTION 11

Please indicate well location X.

ADDITIONAL INFORMATION

If more than one screen, show locations of each on sketch.