

MISSISSIPPI DEPARTMENT OF NATURAL RESOURCES
Bureau of Land and Water Resources
 Southport Mall
 P.O. Box 10631
 Jackson, Mississippi 39209
WATER WELL DRILLERS LOG

Jackson
K0173

7-23-84 19 Coast Water Well Sew. Jackson
 date well completed firm name county well located

LANDOWNER: James Tanner
Rt Box 249A
Ocean Springs, Miss.
 (mailing address) 35164

description of formations encountered	from	to
<u>Top soil</u>	<u>0</u>	<u>8'</u>
<u>Medium Sand</u>	<u>8'</u>	<u>23'</u>
<u>Gray Clay</u>	<u>23'</u>	<u>80'</u>
<u>Coarse sand</u>	<u>80'</u>	<u>140'</u>
<u>5'-2" Tail Pipe</u>		

WELL LOCATION:
 sec. 11 T. 6 S. R. 7 E.
2 miles EAST of Vancleave
 (distance) (direction) (nearest town)

WELL PURPOSE: Home
 (home, irrigation, municipal, industrial)

- WELL COMPLETION DATA:
- (1) diameter (inches) 2"
 - (2) total depth (feet) 140'
 - (3) static water level (feet) 35' below top of ground. above
 - (4) casing PVC, 130'
 (material) (depth)
2" If telescope see back.
 (size)
 - (5) screen 10', 130'
 (length) (depth to top)
2" PVC
 (size) (material)
 - (6) pump 1/2" p.
 (HP) (yield gpm)
Elect.
 (type power)
 - (7) electric log No
 (yes or no)
 (organization running log)

(8) how well bottom plugged
Partial wash valve


DRILLERS REMARKS:

DEPT. OF NATURAL RESOURCES
 BUREAU OF LAND & WATER RESOURCES

OCT 17 1984
RECEIVED

If well telescopes please sketch and show depths.

GROUND LEVEL

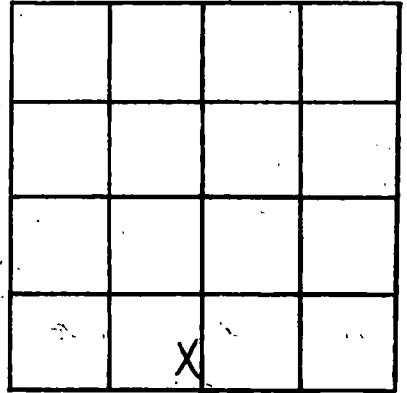

SECTION 11

Please indicate well location X.

ADDITIONAL INFORMATION

Multiple horizontal lines for additional information.

If more than one screen, show locations of each on sketch.