

MISSISSIPPI DEPARTMENT OF NATURAL RESOURCES

Bureau of Land and Water Resources

Southport Mall

P.O. Box 10631

Jackson, Mississippi 39209

WATER WELL DRILLERS LOG

Jackson  
K2174

8-27-84  
date well completed

Coast Water Well Sew.  
firm name

Jackson  
county well located

LANDOWNER: Frank Burt

Rt 4 - Box 224A -  
Ocean Springs, Miss  
(mailing address) 37564

WELL LOCATION:  
sec. 14 T. 6 S. R. 7 E.  
2 1/2 miles East of Sardine  
(distance) (direction) (nearest town)

WELL PURPOSE: Home  
(home, irrigation, municipal, industrial)

WELL COMPLETION DATA:

- (1) diameter (inches) 2"
- (2) total depth (feet) 120'
- (3) static water level (feet) 50' below top of ground.
- (4) casing PVC, 110' (material), (depth).  
2" (size) If telescope see back.
- (5) screen 10' (length), 110' (depth to top).  
2" (size), PVC (material)
- (6) pump (HP) (yield gpm)  
Elect. (type power)
- (7) electric log No (yes or no)  
(organization running log)
- (8) how well bottom plugged Back wash valve

description of formations encountered	from	to
Top soil	0	5'
Red Clay	5'	15'
Coarse Sand	15'	50'
White Clay	50'	75'
Med sand	75'	120'


DRILLERS REMARKS:

DEPT. OF NATURAL RESOURCES  
BUREAU OF LAND & WATER RESOURCES

OCT 12 1984  
RECEIVED

If well telescopes please sketch and show depths.

GROUND LEVEL

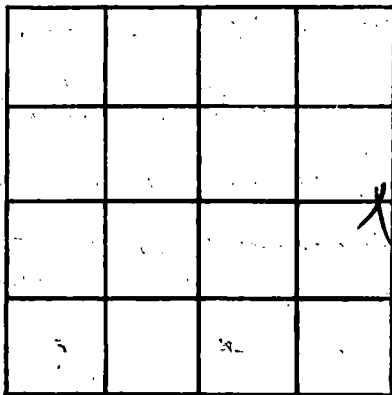

SECTION 14

Please indicate well location X.

**ADDITIONAL INFORMATION**

A series of horizontal lines for writing additional information, starting below the 'ADDITIONAL INFORMATION' header and extending to the bottom of the page.

If more than one screen, show locations of each on sketch.