

MISSISSIPPI DEPARTMENT OF NATURAL RESOURCES

Bureau of Land and Water Resources

Southport Mall

P.O. Box 10631

Jackson, Mississippi 39209

WATER WELL DRILLERS LOG

Jackson  
K 2175

8-27-84 19 Crosswater Well Sew. Jackson  
date well completed firm name county well located

LANDOWNER W.W. Schmidt  
Rt 4 Box 209-B.  
Ocean Springs, Miss.  
(mailing address) 32564

WELL LOCATION:  
sec. 24 T. 6 N. R. 7 E.  
4 miles SE of Vandeventer  
(distance) (direction) (nearest town)

WELL PURPOSE: Home  
(home, irrigation, municipal, industrial)

- WELL COMPLETION DATA:
- (1) diameter (inches) 2"
  - (2) total depth (feet) 120'
  - (3) static water level (feet) 55 (below/above top of ground)
  - (4) casing PVC 110'  
(material) (depth)
  - 2"  
(size) if telescope see back.
  - (5) screen 10' 110'  
(length) (depth to top)
  - 2" PVC  
(size) (material)
  - (6) pump 1 h.p. 8  
(HP) (yield gpm)
  - elect.  
(type power)
  - (7) electric log No  
(yes or no)
  - (organization running log)
  - (8) how well bottom plugged Back Wash Valve

description of formations encountered	from	to
<u>Sandy Top Soil</u>	<u>0</u>	<u>5'</u>
<u>Red Clay</u>	<u>5'</u>	<u>18'</u>
<u>Coarse Sand</u>	<u>18'</u>	<u>43'</u>
<u>W. Clay</u>	<u>43'</u>	<u>68'</u>
<u>Med. Sand</u>	<u>68'</u>	<u>115'</u>
<u>5' x 2" PVC Tail Pipe</u>		<u>120'</u>


DRILLERS REMARKS:

DEPT. OF NATURAL RESOURCES  
BUREAU OF LAND AND WATER RESOURCES

OCT 12 1984  
RECEIVED

If well telescopes please sketch and show depths.

GROUND LEVEL

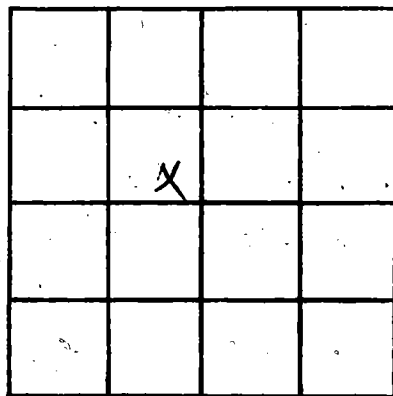

SECTION 24

Please indicate well location X.

ADDITIONAL INFORMATION

If more than one screen,  
show locations of each on sketch.