

MISSISSIPPI DEPARTMENT OF NATURAL RESOURCES
Bureau of Land and Water Resources
 Southport Mall
 P.O. Box 10631
 Jackson, Mississippi 39209
WATER WELL DRILLERS LOG

Jackson
R2176

19 10584 Jayloke well Jackson
 date well completed firm name county well located

LANDOWNER: H L Harvey
P O Box 537
Vandover MS 39567
 (mailing address)

WELL LOCATION:
 sec 5 T 6 N R 7 E
2 miles NE of Vandover
 (distance) (direction) (nearest town)

WELL PURPOSE:
 (home, irrigation, municipal, industrial)

WELL COMPLETION DATA:

(1) diameter (inches) 2"

(2) total depth (feet) 265

(3) static water level (feet) 68 below above top of ground.

(4) casing PVC, 260,
 (material) (depth)

no. If telescope see back.
 (size)

(5) screen 5ft 6, 260
 (length) (depth to top)

2", PVC,
 (size) (material)

(6) pump 1 10
 (HP) (yield gpm)

Elect
 (type power)

(7) electric log no
 (yes or no) no
 (organization running log)

(8) how well bottom plugged PVC
Ballchuff

description of formations encountered	from	to
Top Soil	0	10
Sand	10	20
Clay	20	50
Sand, Brown	50	80
Sand "	80	120
Sand	120	140
Sand	140	220
Sand	220	265

DRILLERS REMARKS: Well off.


DEPT. OF NATURAL RESOURCES
 BUREAU OF LAND AND WATER RESOURCES

DEC 13 1984

RECEIVED

If well telescopes please sketch and show depths.

GROUND LEVEL

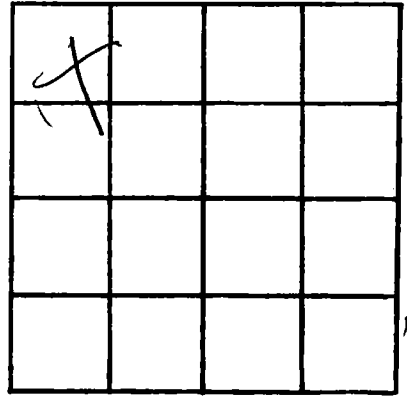

SECTION 3

Please indicate well location X.

ADDITIONAL INFORMATION

A series of horizontal lines for writing additional information.

If more than one screen, show locations of each on sketch.