

MISSISSIPPI DEPARTMENT OF NATURAL RESOURCES

Bureau of Land and Water Resources

Southport Mall

P.O. Box 10631

Jackson, Mississippi 39209

WATER WELL DRILLERS LOG

Jackson  
K2179

6/24 1984 Fry Fork Water Well Jackson  
date well completed firm name county well located

LANDOWNER: Paul Batsol  
D.C. Boy  
Vandeventer MS 39564  
(mailing address)

WELL LOCATION:  
sec 2 T 6 N R 7 E  
10 miles SE of Vandeventer  
(distance) (direction) (nearest town)

WELL PURPOSE: Home  
(home, irrigation, municipal, industrial)

WELL COMPLETION DATA:  
(1) diameter (inches) 2"  
(2) total depth (feet) 270  
(3) static water level (feet) 40 below above top of ground.  
(4) casing PVC 240'  
(material) (depth)  
2' (size) if telescope see back.  
(5) screen 10' 230'  
(length) (depth to top)  
#6 PVC  
(size) (material)  
(6) pump 1 (HP) 7 (yield gpm)  
ELEC  
(type power)  
(7) electric log NO  
(yes or no)  
(organization running log) PVC Batsol  
(8) how well bottom plugged

description of formations encountered	from	to
Topsoil + sand	0	20
clay	20	25
sand	25	45
clay	45	55
sand	55	100
clay	100	110
sand	110	140
clay	140	165
sand	165	180
clay	180	220
sand	220	240

DEPT. OF NATURAL RESOURCES  
BUREAU OF LAND & WATER RESOURCES


DEC 13 1984

RECEIVED

DRILLERS REMARKS:

If well telescopes please sketch and show depths.

GROUND LEVEL

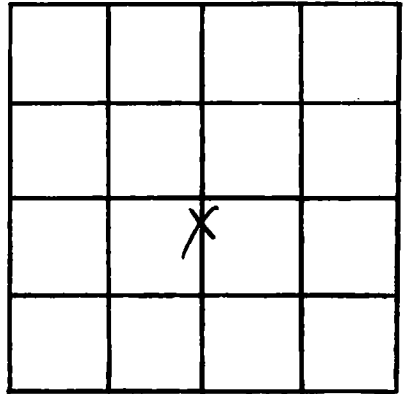

SECTION 24

Please indicate well location X.

ADDITIONAL INFORMATION

If more than one screen, show locations of each on sketch.