

**MISSISSIPPI DEPARTMENT OF NATURAL RESOURCES**  
**Bureau of Land and Water Resources**  
 Southport Mall  
 P.O. Box 10631  
 Jackson, Mississippi 39209  
**WATER WELL DRILLERS LOG**

Jackson  
K2178

7-20-84 19 try Josh Well Serv. Jackson  
 date well completed firm name county well located

LANDOWNER: Don Hughes  
Uncle MS. 39564  
 (mailing address)

WELL LOCATION:  
 sec. 5 T 6 N R 7 E  
3 miles E of Uncle  
 (distance) (direction) (nearest town)

WELL PURPOSE:  
 (home, irrigation, municipal, industrial)

- WELL COMPLETION DATA:
- (1) diameter (inches) 2"
  - (2) total depth (feet) 300'
  - (3) static water level (feet) 60 below above top of ground.
  - (4) casing PVC, 290'  
 (material) (depth)  
~~2 1/2" IP~~ telescope see back.  
 (size)
  - (5) screen 10', 290'  
 (length) (depth to top)  
2", PVC  
 (size) (material)
  - (6) pump 1 HP, 10  
 (HP) (yield gpm)  
Elect  
 (type power)
  - (7) electric log no  
 (yes or no)  
no  
 (organization running log)
  - (8) how well bottom plugged PVC  
Ball Check

description of formations encountered	from	to
<u>top Soil</u>	<u>0</u>	<u>10</u>
<u>Clay</u>	<u>10</u>	<u>30</u>
<u>Small Clay Strakes</u>	<u>30</u>	<u>50</u>
<u>Sand</u>	<u>50</u>	<u>52</u>
<u>5 gal. Casal</u>	<u>52</u>	<u>82</u>
<u>Clay</u>	<u>82</u>	<u>120</u>
<u>Sand</u>	<u>120</u>	<u>135</u>
<u>Clay</u>	<u>135</u>	<u>265</u>
<u>Sand</u>	<u>265</u>	<u>300</u>

DEPT. OF NATURAL RESOURCES  
 BUREAU OF LAND & WATER RESOURCES


DEC 13 1984

**RECEIVED**

DRILLERS REMARKS:

**if well telescopes please  
sketch and show depths.**

**GROUND LEVEL**

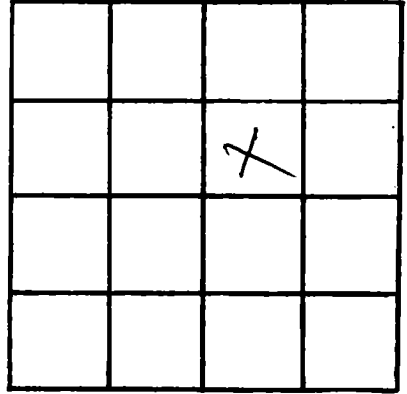

**SECTION** B

**Please indicate well location X.**

**ADDITIONAL INFORMATION**

**If more than one screen,  
show locations of each on sketch.**