

MISSISSIPPI DEPARTMENT OF NATURAL RESOURCES

Bureau of Land and Water Resources

Southport Mall

P.O. Box 10631

Jackson, Mississippi 39209

WATER WELL DRILLERS LOG

Jackson
K2182

11-12-84
date well completed

19 Coast Water Well Serv.
firm name

Jackson
county well located

OWNER: Charles Edmondson

1320 Finley Rd.

Ocean Springs, Miss.
(mailing address) 37524

WELL LOCATION:

sec. 29 T. 6 N. R. 7 E.
2 1/2 miles (distance) S (direction) of VANCLIFFE (nearest town)

WELL PURPOSE: Home
(home, irrigation, municipal, industrial)

WELL COMPLETION DATA:

- (1) diameter (inches) 2"
- (2) total depth (feet) 165'
- (3) static water level (feet) 50' below
top of ground. above
- (4) casing PVC (material) 155' (depth)
- 2" (size) if telescope see back.
- (5) screen 10' (length) 155' (depth to top)
- 2" (size) PVC (material)
- (6) pump R.P. (type) 8 1/2 (yield gpm)
- Elec. (type power)
- (7) electric log No (yes or no)

(organization running log)

(8) has well bottom plugged?
Each rock valve

description of formations encountered

description of formations encountered	from	to
<u>Top soil</u>	<u>0</u>	<u>3'</u>
<u>Red Clay</u>	<u>3'</u>	<u>25'</u>
<u>Gray Clay</u>	<u>25'</u>	<u>45'</u>
<u>Coarse Sand</u>	<u>45'</u>	<u>68'</u>
<u>Gray Clay</u>	<u>68'</u>	<u>105'</u>
<u>Med. Sand</u>	<u>105'</u>	<u>165'</u>


5 ft. 2" Well Pipe

1-8-85
RWC

DRILLERS REMARKS: _____

If well telescopes please sketch and show depths.

GROUND LEVEL

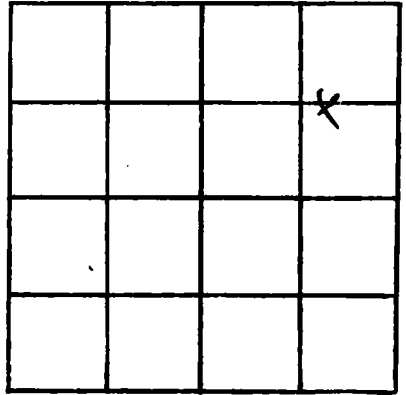

SECTION 29

Please indicate well location X.

ADDITIONAL INFORMATION

If more than one screen, show locations of each on sketch.