

MISSISSIPPI DEPARTMENT OF NATURAL RESOURCES

Bureau of Land and Water Resources

Southport Mall

P.O. Box 10631

Jackson, Mississippi 39209

WATER WELL DRILLERS LOG

K 2185
 JACKSON
 12-24-84

12-24 1984 date well completed
 Coast Water Well Sew. Jackson firm name
 county well located

LANDOWNER: Lanette Hird
 210 Coledge Ave.
 Biloxi, Miss.
 (mailing address) 39531

WELL LOCATION:
 sec. 11 T. 6 N. R. 7 E.
2 miles East Vanhook
 (distance) (direction) (nearest town)

WELL PURPOSE: home
 (home, irrigation, municipal, industrial)

WELL COMPLETION DATA:
 (1) diameter (inches) 2"
 (2) total depth (feet) 265'
 (3) static water level (feet) 105' ^{below} above top of ground.
 (4) casing PVC 250
 (material) (depth)
2" If telescope see back.
 (size)
 (5) screen 10' 250
 (length) (depth to top)
2" PVC
 (size) (material)
 (6) pump 2 8
 (HP) (yield gpm)
elec
 (type power)
 (7) electric log No
 (yes or no)
 (organization running log)
 (8) how well bottom plugged tail pipe
Backwash valve

description of formations encountered	from	to
Top Soil	0	3
Red Clay	3	21
Blue Clay	21	70
Med. Sand	70	140
Blue Clay	140	205
Med. Fine Sand	205	219
Blue Clay	219	235
Gray Coarse Sand	235	260
5' Tail Pipe		

RECEIVED


APR 2 1985

Department of Natural Resources
 Bureau of Land & Water Resources

DRILLERS REMARKS:

If well telescopes please sketch and show depths.

GROUND LEVEL

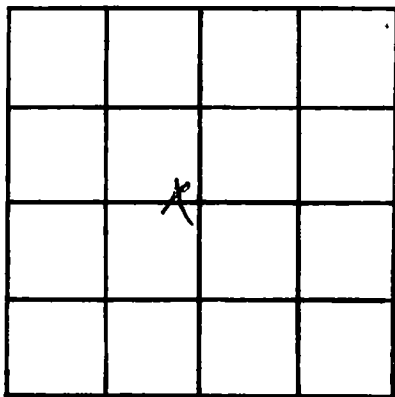

SECTION 11

Please indicate well location X.

ADDITIONAL INFORMATION

If more than one screen, show locations of each on sketch.