

MISSISSIPPI DEPARTMENT OF NATURAL RESOURCES

Bureau of Land and Water Resources

Southport Mall

P.O. Box 10631

Jackson, Mississippi 39209

WATER WELL DRILLERS LOG

2186
JACKSON
12-21-84

12-21-84 date well completed
Cross Water Well Sew. firm name
Jackson county well located

LANDOWNER: Carl Cain
Rt 2 - Box 311 G.
Ocean Springs, Miss.
(mailing address) 39564

WELL LOCATION:
sec. 9 T. 6 N R. 7 E
1 N miles of Vandlen
(distance) (direction) (nearest town)

WELL PURPOSE: Home
(home, irrigation, municipal, industrial)

WELL-COMPLETION DATA:

- (1) diameter (inches) 2"
- (2) total depth (feet) 279'
- (3) static water level (feet) 30 below top of ground
- (4) casing PVC 269' (material) (depth)
2" (size) If telescope see back.
- (5) screen 10' 269' (length) (depth to top)
2" PVC (size) (material)
- (6) pump 1/2 HP 9 (HP) (yield gpm)
ELECT (type power)
- (7) electric log No (yes or no)

(8) how well bottom plugged Back wash valve

DRILLERS REMARKS:

description of formations encountered	from	to
Red Clay	0	10'
White sand	10'	105'
Blue Clay	105'	236'
White coarse sand (5 ft PVC Tail pipe)	236'	279'


RECEIVED

APR 2 1985

Department of Natural Resources
Bureau of Land & Water Resources

If well telescopes please sketch and show depths.

GROUND LEVEL

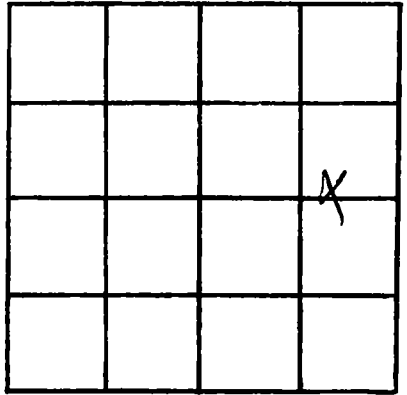

SECTION 9

Please indicate well location X.

ADDITIONAL INFORMATION

If more than one screen, show locations of each on sketch.